


PASTER

PARENT PARCEL: 04-00-017-101-051

NO. 00810-A

CHILD PARCEL:

STARTING POINT: INT C.L. AVON BELDEN AND WEBBER RD

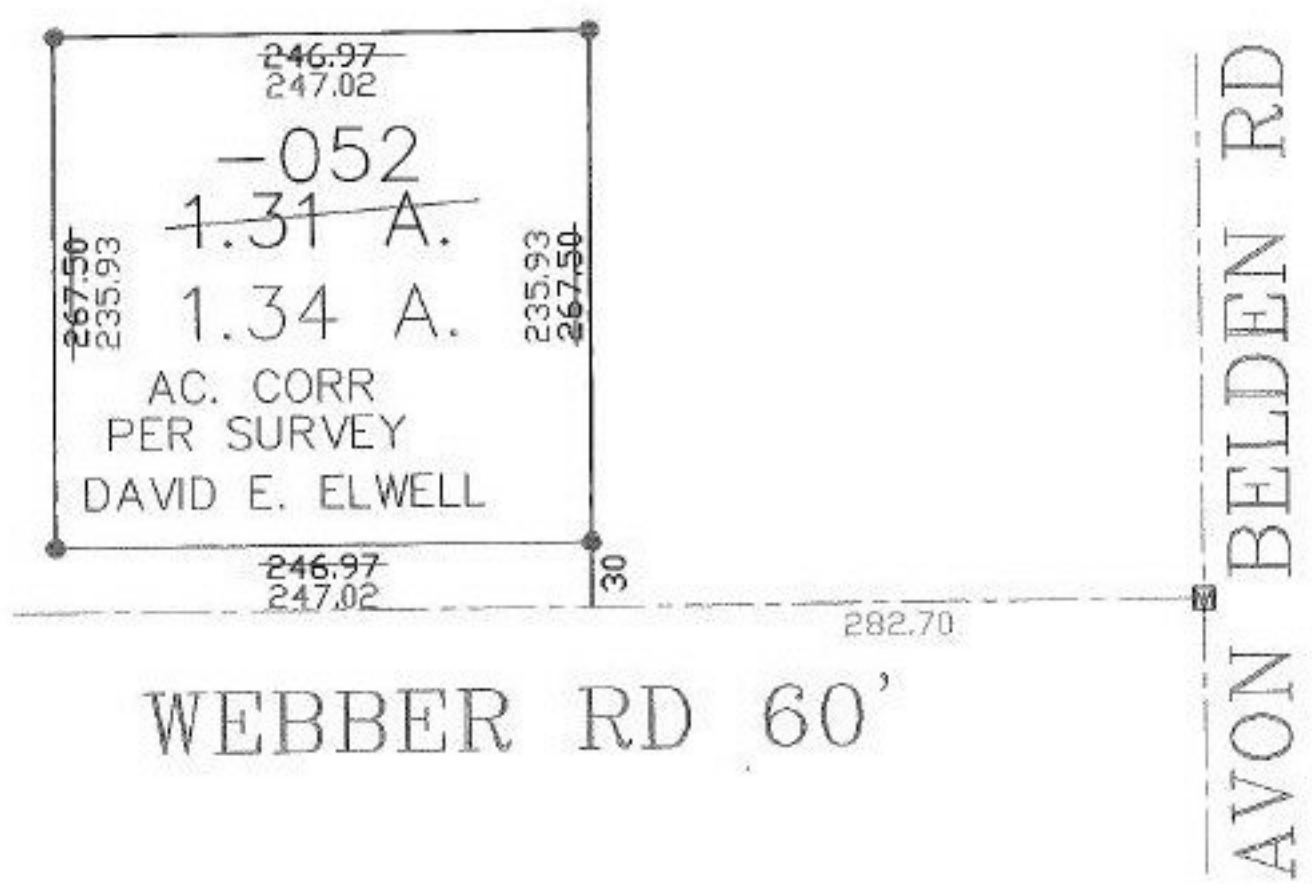

SPLITS/DEEDS PROCESSED

LORAIN COUNTY TAX MAP DEPARTMENT
226 MIDDLE AVE. ELYRIA, OHIO

SURVEYED BY: DAVID E. ELWELL

CLOSURE: 0:00

MAP PAGE(S):

APPROVED BY: DRH DATE: 3/12/2003

SCALE: 1" = 100' PRIOR INSTRUMENT: 20030882384