

MASTER

PARENT PARCEL: 03-00-107-104-034, 03-00-112-102-026

CHILD PARCEL:


STARTING POINT: INT C.L. ELYRIA AVE AND NE CORNER OF PARCEL 03-00-107-104-030

NO. 00811-A

AC. CORR PER
DEED



ELYRIA
AVE

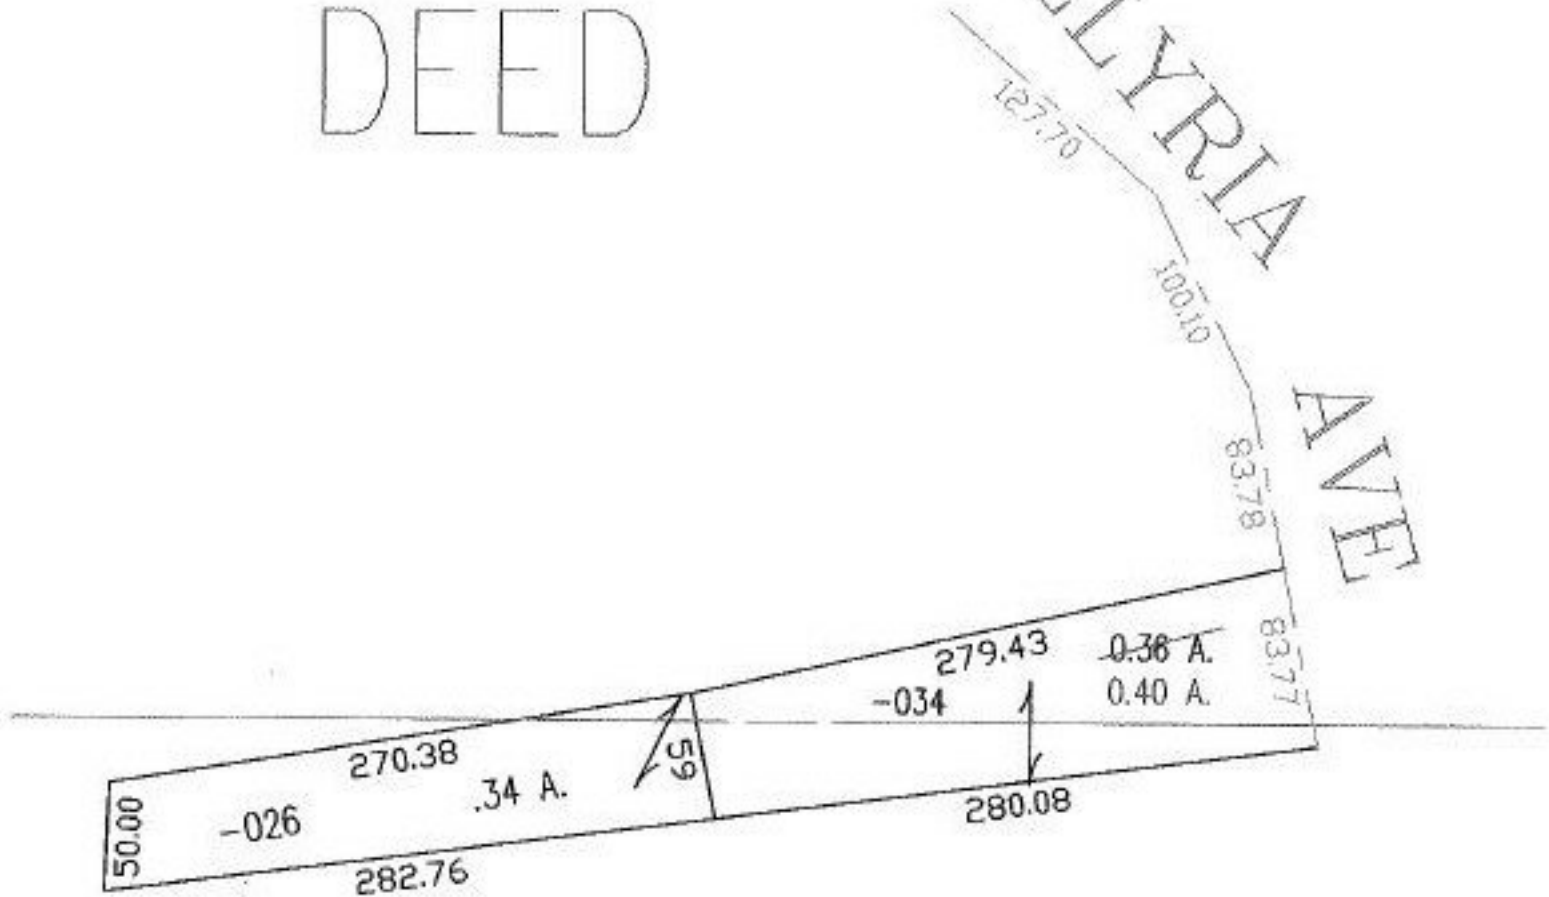

SPLITS/DEEDS PROCESSED

LORAIN COUNTY TAX MAP DEPARTMENT
226 MIDDLE AVE. ELYRIA, OHIO

SURVEYED BY: _____

CLOSURE: 0:00

MAP PAGE(S): 03-00-107-B, 03-00-112-B

APPROVED BY: DRH DATE: 3/5/03

SCALE: 1" = 100' PRIOR INSTRUMENT: D.V. 1124/319