

PARENT PARCEL: 02-01-003-116-030

CHILD PARCEL: 02-01-003-116-098 & -099

STARTING POINT: XXXXXX

NO. 00826-V

PARTIAL PARK VACATION

~~02-01-003-116-030~~


~~1.12 A.~~

02-01-003-116-098

0.01 A.

02-01-003-116-099

1.11 A.

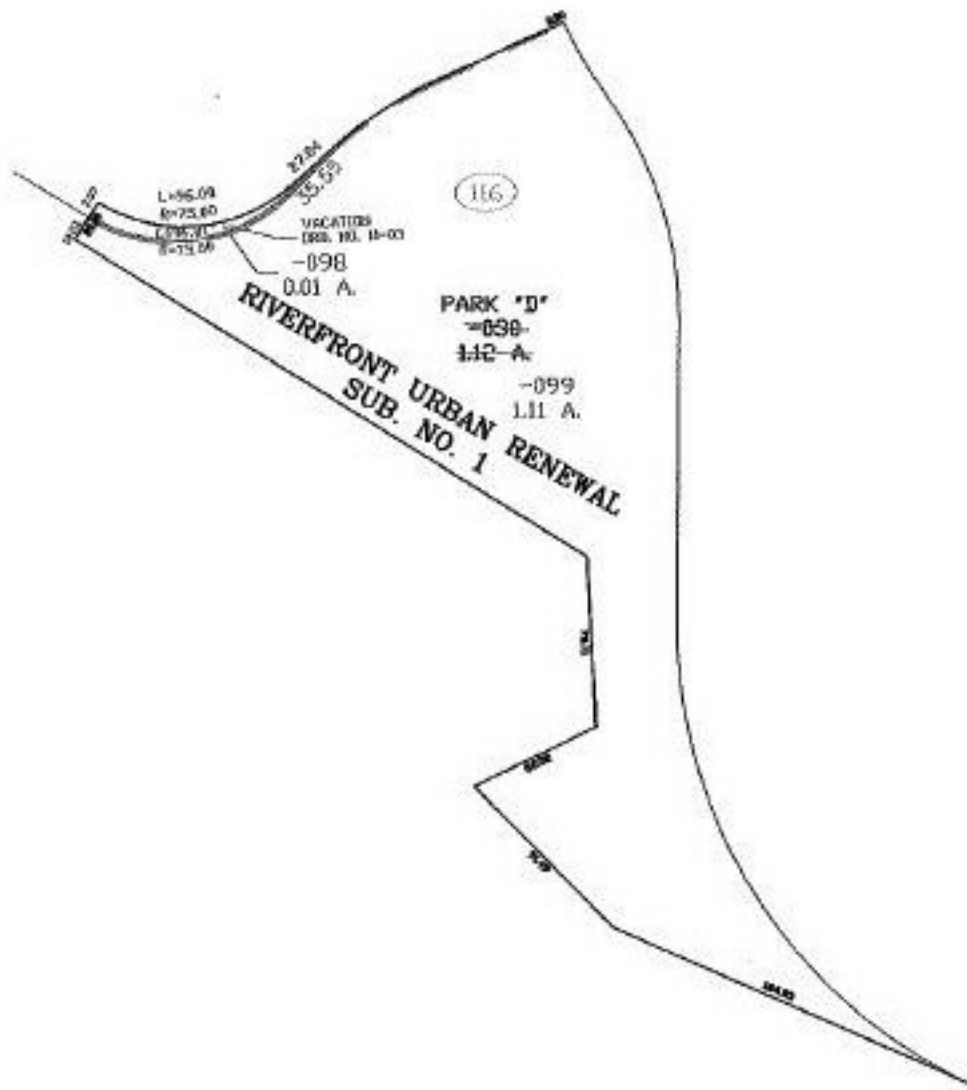

SPLITS/DEEDS PROCESSED

LORAIN COUNTY TAX MAP DEPARTMENT
226 MIDDLE AVE. ELYRIA, OHIO

SURVEYED BY: M. BRAMHALL

CLOSURE: 0.00 : 10.000

MAP PAGE(S): 02-01-003-A

APPROVED BY: TJS DATE: 3/12/03

SCALE: 1" = 100' PRIOR INSTRUMENT: DV XXXX/XXX