

RASTER

PARENT PARCEL: 09-00-076-104-004


CHILD PARCEL: SAME

STARTING POINT:

NO. 00828-A



PARK ST

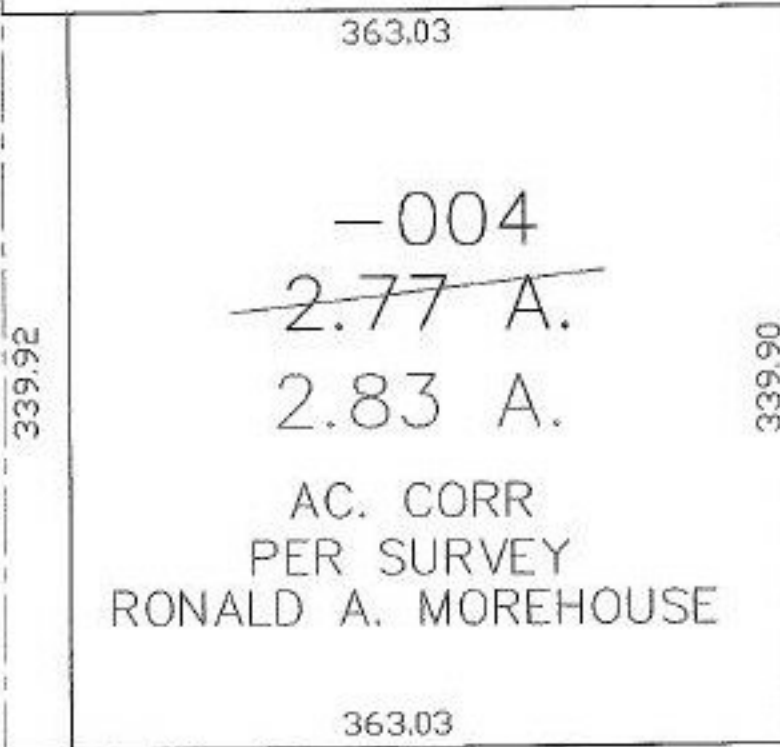

SPLITS/DEEDS PROCESSED

LORAIN COUNTY TAX MAP DEPARTMENT  
226 MIDDLE AVE. ELYRIA, OHIO

SURVEYED BY: RONALD A. MOREHOUSE

CLOSURE: 0:00

MAP PAGE(S): 09-00-076-B

APPROVED BY: DRH DATE: 3/18/2003

SCALE: 1" = 100' PRIOR INSTRUMENT: