
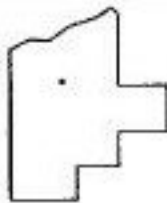


PARENT PARCEL: 09-00-003-105-006

CHILD PARCEL: SAME

STARTING POINT: INT C.L. PYLE SOUTH AMHERST RD AND NORTH LINE OF RUSSIA TWP

NO. 00829-X

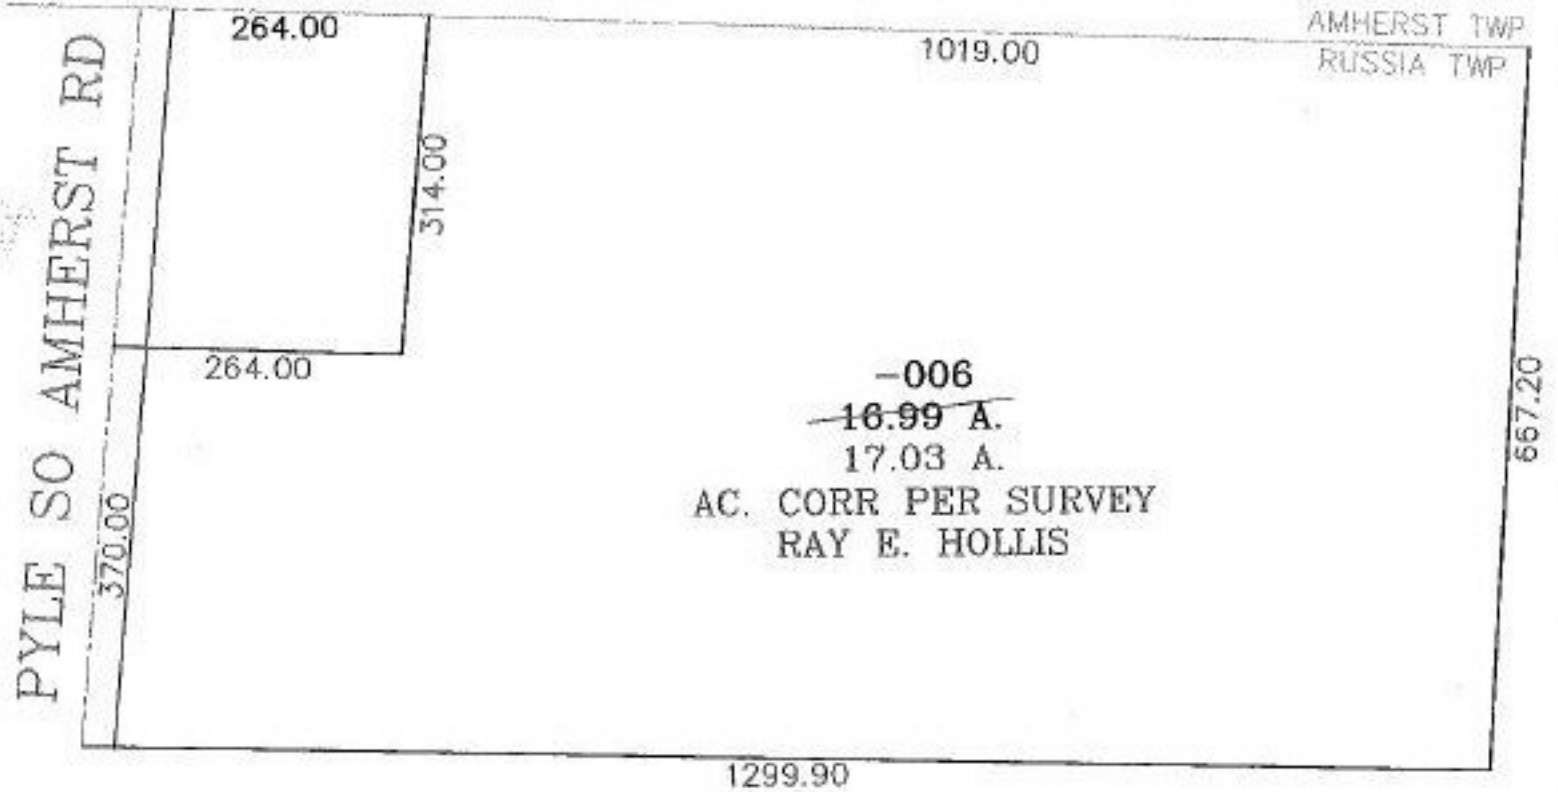

SPLITS/DEEDS PROCESSED
LORAIN COUNTY TAX MAP DEPARTMENT
 226 MIDDLE AVE. ELYRIA, OHIO

SURVEYED BY: RAY E. HOLLIS
 CLOSURE: 0:00
 MAP PAGE(S): 09-00-003-B, 5-F
 APPROVED BY: DRH DATE: 3/19/2003
 SCALE: 1" = 200' PRIOR INSTRUMENT: O.R. 1428/428