


PARENT PARCEL: 04-00-007-711-001 THRU -010

CHILD PARCEL: 04-00-006-800-001, 04-00-006-801-001 THRU -010

STARTING POINT: XXXXXX

NO. 00833-C

RE-NUMBER

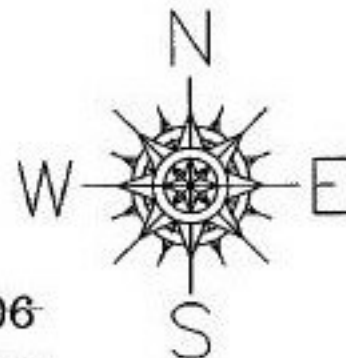

~~04-00-006-711-001~~
04-00-006-801-001
17.79 X 50.04

~~04-00-006-711-006~~
04-00-006-801-006
18.01 X 50.03

~~04-00-006-711-002~~
04-00-006-801-002
18.04 X 50.04

~~04-00-006-711-007~~
04-00-006-801-007
17.95 X 49.97

~~04-00-006-711-003~~
04-00-006-801-003
18.10 X 50.08

~~04-00-006-711-008~~
04-00-006-801-008
17.97 X 49.97

~~04-00-006-711-004~~
04-00-006-801-004
18.05 X 50.08


~~04-00-006-711-009~~
04-00-006-801-009
17.93 X 50.00

~~04-00-006-711-005~~
04-00-006-801-005
17.94 X 50.03

~~04-00-006-711-010~~
04-00-006-801-010
18.10 X 50.00

ADD TO DUP.

04-00-006-800-001
13.51 A.

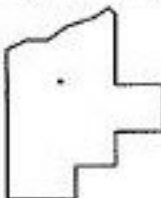

SPLITS/DEEDS PROCESSED

LORAIN COUNTY TAX MAP DEPARTMENT
226 MIDDLE AVE. ELYRIA, OHIO

SURVEYED BY: RALPH M. GUGAR

CLOSURE: XXXXXX

MAP PAGE(S): 4-00-006-H

APPROVED BY: TJS DATE: 4/4/03

SCALE: 1" = 100' PRIOR INSTRUMENT: DV XXXX/XXX