

RASTFR

PARENT PARCEL: 06-25-002-113-001


NO. 00837-A

CHILD PARCEL:

STARTING POINT: POINT IN W LINE OF O.L. 2



UPDATE LEGAL BETTER PLACE OF BEGINNING

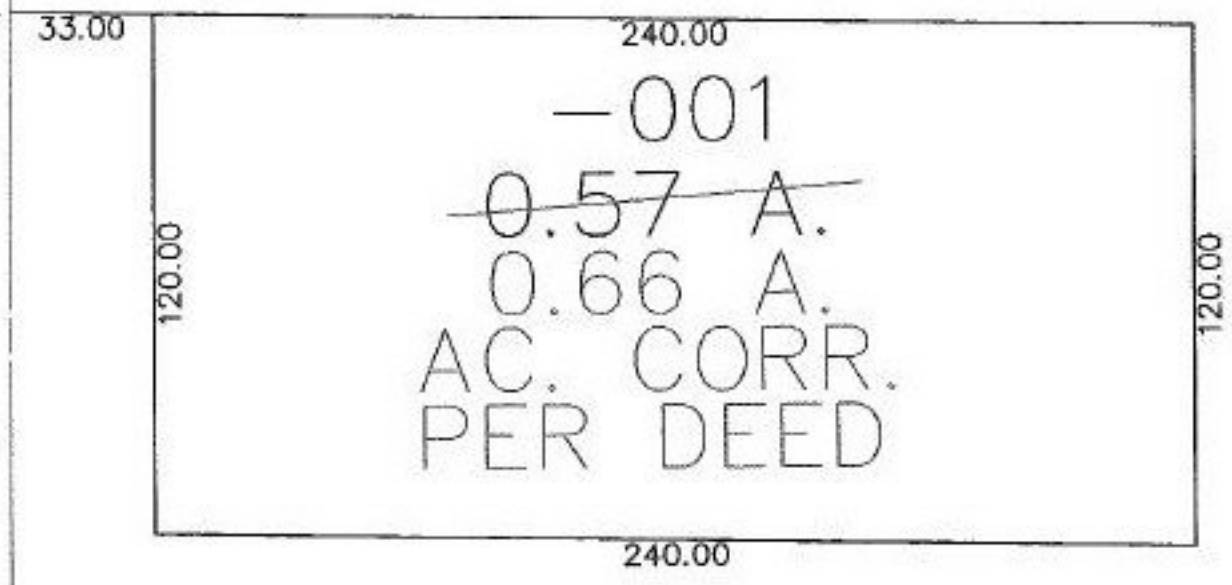

SPLITS/DEEDS PROCESSED
LORAIN COUNTY TAX MAP DEPARTMENT
 226 MIDDLE AVE. ELYRIA, OHIO

SURVEYED BY: T. W. LAUNDON
 CLOSURE: 0.00:000
 MAP PAGE(S): 6-141
 APPROVED BY: DRH DATE: 4/4/2003
 SCALE: 1" = 50' PRIOR INSTRUMENT: 489/475