


PARENT PARCEL: 11-00-095-000-009, -010

CHILD PARCEL: SAME

STARTING POINT:

NO. 00838-X

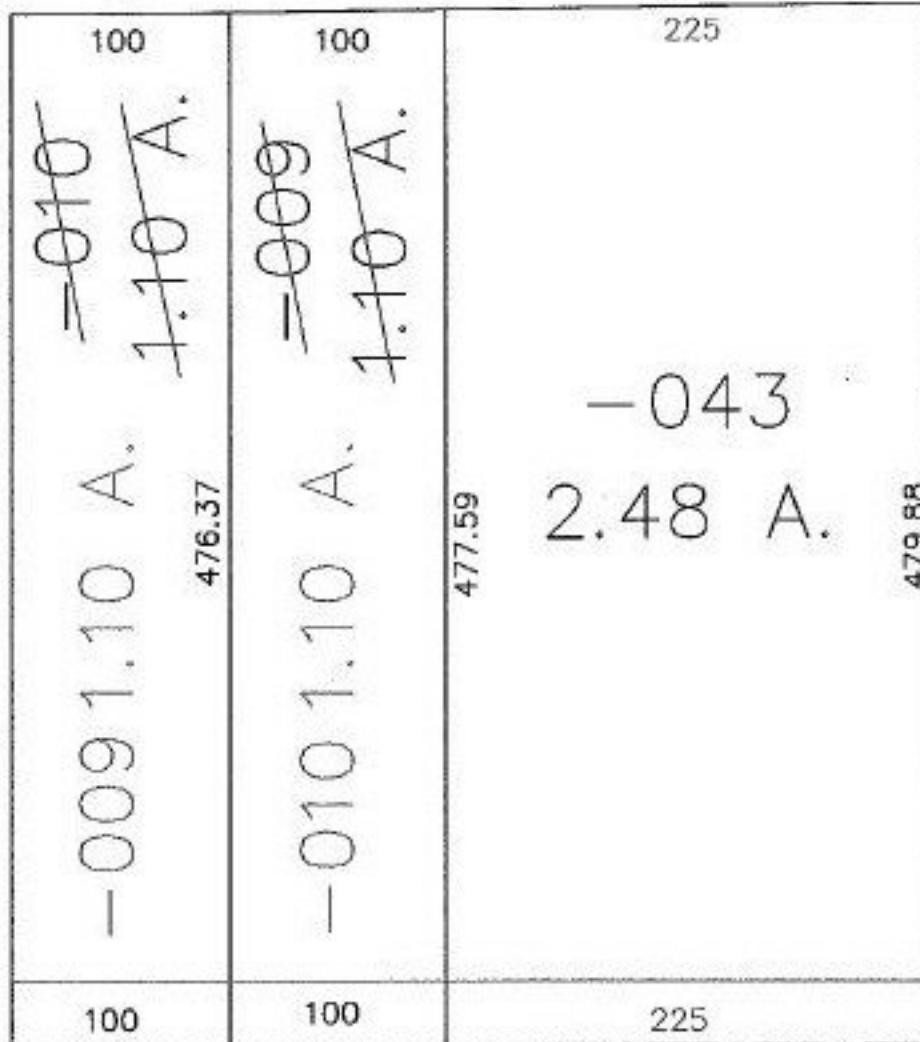

ELYRIA - TWINSBURG



SPLITS/DEEDS PROCESSED

LORAIN COUNTY TAX MAP DEPARTMENT
226 MIDDLE AVE. ELYRIA, OHIO

SURVEYED BY: J. W. WARDEN
CLOSURE: 0:00
MAP PAGE(S): ~~11-00-095-000-009~~ 11-00-095-13
APPROVED BY: DRH DATE: 3/10/03
SCALE: 1" = 100' PRIOR INSTRUMENT: 1657/207