


PARENT PARCEL: 04-00-006-112-061, -062, -065, -066

CHILD PARCEL: XX-XX-XXX-XXX-XXX

STARTING POINT: XXXXXX

NO. 00839-C

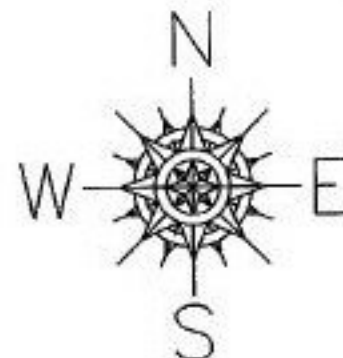

FRONTAGE & DEPTH CORR.

04-00-006-112-061

~~20 X 145~~

20 X 140

04-00-006-112-062

~~20 X 145~~

20 X 140

04-00-006-112-065

~~20 X 145~~

20 X 140

04-00-006-112-066

~~20 X 145~~

20 X 140



**SPLITS/DEEDS PROCESSED**  
LORAIN COUNTY TAX MAP DEPARTMENT  
226 MIDDLE AVE. ELYRIA, OHIO

SURVEYED BY: RALPH M. GUGAR

CLOSURE: XXXXXX

MAP PAGE(S): 4-00-006-H

APPROVED BY: TJS DATE: 04/08/03

SCALE: 1" = 100' PRIOR INSTRUMENT: DV XXXX/XXX