


PARENT PARCEL: 03-00-083-101-037


CHILD PARCEL: 03-00-083-101-037

STARTING POINT: GROVE AVE & E 28TH ST.

NO. 00849-A1

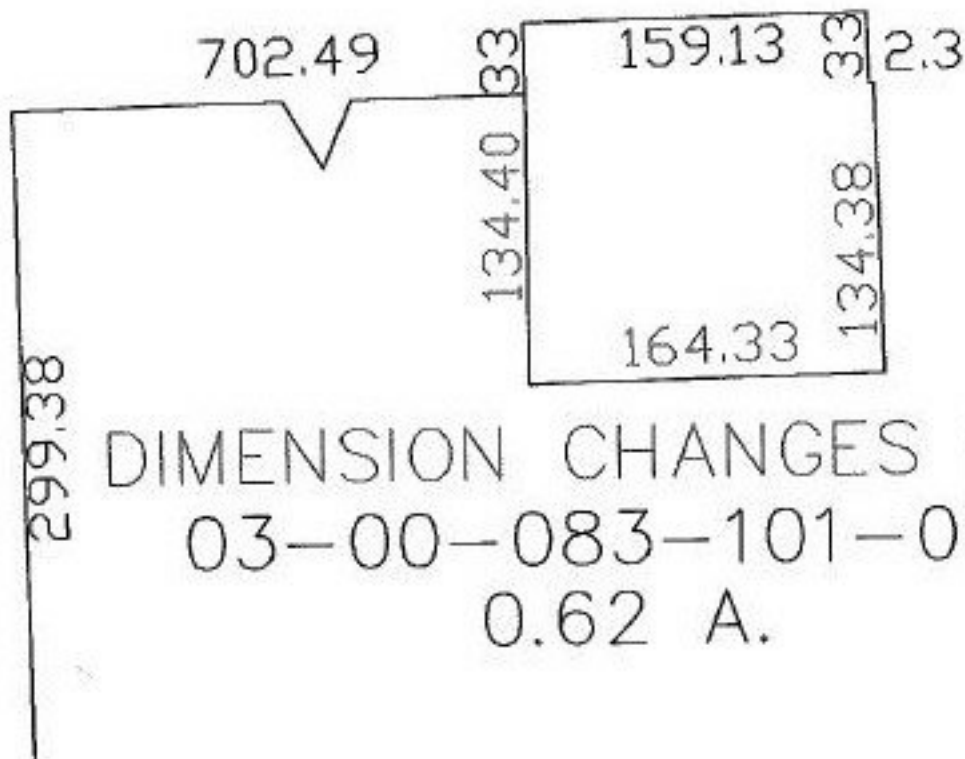

DIMENSION CHANGES ONLY
 03-00-083-101-037
 0.62 A.

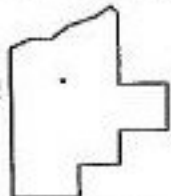

SPLITS/DEEDS PROCESSED

LORAIN COUNTY TAX MAP DEPARTMENT
226 MIDDLE AVE. ELYRIA, OHIO

SURVEYED BY: MICHAEL STRAUB

CLOSURE: 0.00 : 10.000

MAP PAGE(S): 3-A, 3-B, 3-E, 3-F

APPROVED BY: JAH DATE: 5-7-03

SCALE: 1" = 100' PRIOR INSTRUMENT: 20020850503