


PARENT PARCEL: 03-00-088-101-016

CHILD PARCEL: 03-00-088-101-016

STARTING POINT: GROVE AVE. & E 28TH ST.

NO. 00849-A3

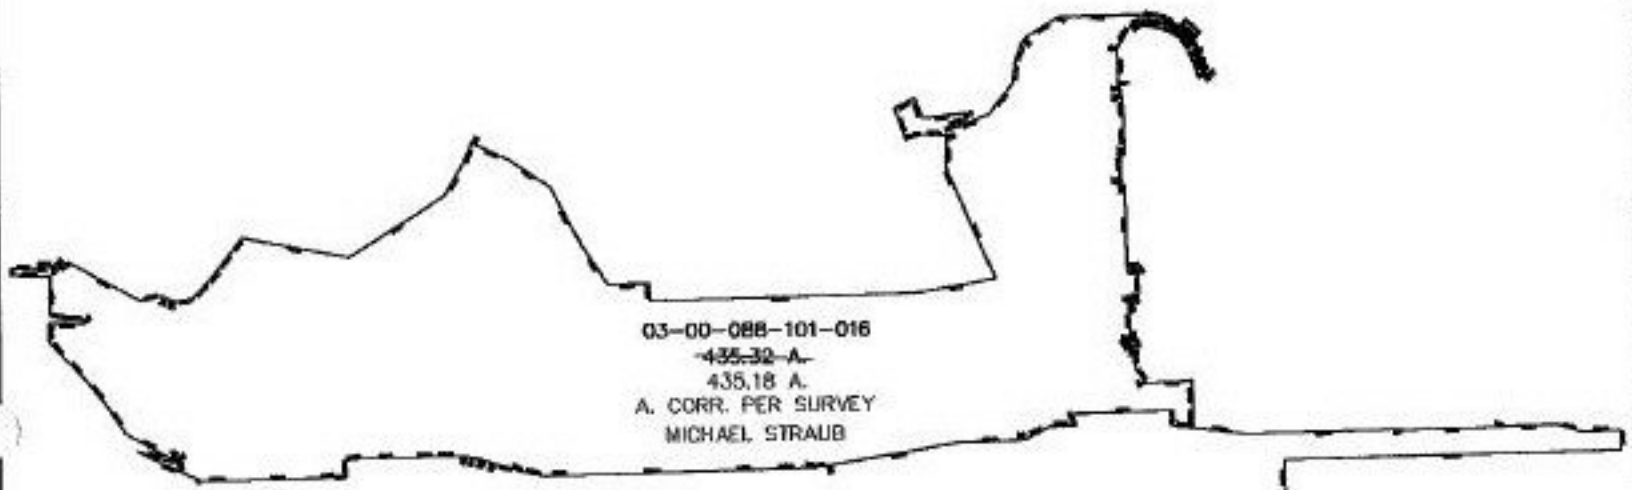

03-00-088-101-016  
~~435.32 A.~~  
435.18 A.  
A. CORR. PER SURVEY  
MICHAEL STRAUB

03-00-088-101-016

~~435.32 A.~~

435.18 A.

A. CORR. PER SURVEY

MICHAEL STRAUB



SPLITS/DEEDS PROCESSED

LORAIN COUNTY TAX MAP DEPARTMENT  
226 MIDDLE AVE. ELYRIA, OHIO

SURVEYED BY: MICHAEL STRAUB

CLOSURE: 0.00 : 10.000

MAP PAGE(S): 3-A, 3-B, 3-E, 3-F, 3-G

APPROVED BY: JAH DATE: 5-7-03

SCALE: 1" = 1900' PRIOR INSTRUMENT: 20020850503