
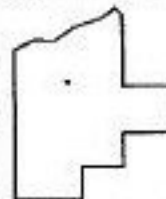


PARENT PARCEL: 03-00-088-101-021

CHILD PARCEL: 03-00-088-101-021

STARTING POINT: PEARL AVE & E 28TH ST.

NO. 00849-A4

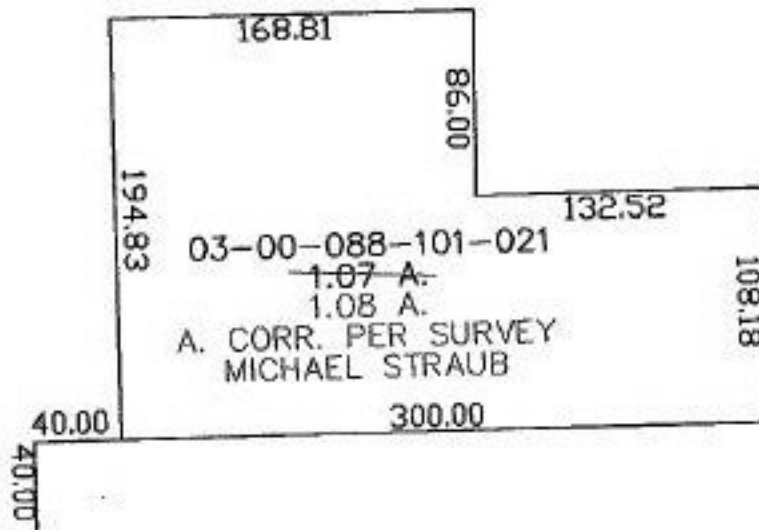

**SPLITS/DEEDS PROCESSED**

LORAIN COUNTY TAX MAP DEPARTMENT  
226 MIDDLE AVE. ELYRIA, OHIO

SURVEYED BY: MICHAEL STRAUB

CLOSURE: 0.00 : 10.000

MAP PAGE(S): 3-A, 3-B, 3-E, 3-F, 3-G

APPROVED BY: JAH DATE: 5-7-03

SCALE: 1" = 100. PRIOR INSTRUMENT: ADD TO DUP