


PARENT PARCEL: 03-00-088-101-020

CHILD PARCEL: 03-00-088-101-020

STARTING POINT: PEARL AVE & E28TH ST.

NO. 00849-A5

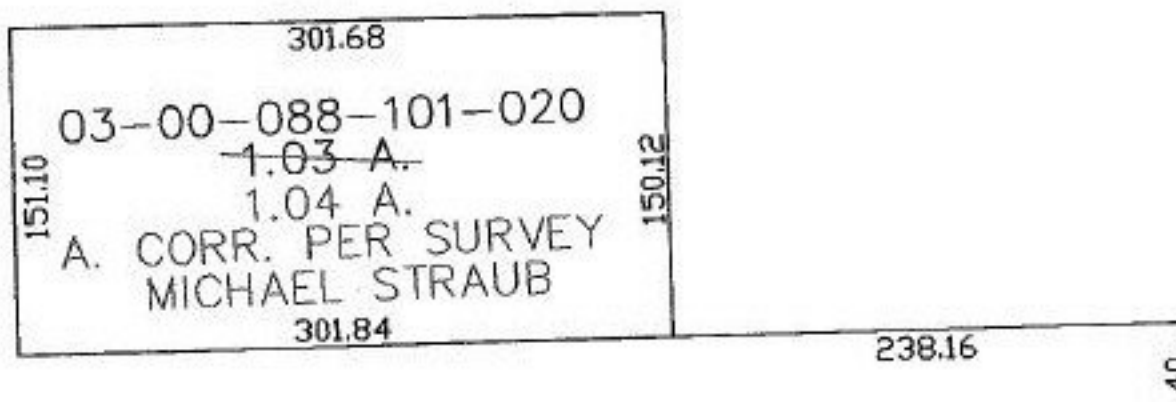

SPLITS/DEEDS PROCESSED

LORAIN COUNTY TAX MAP DEPARTMENT
226 MIDDLE AVE. ELYRIA, OHIO

SURVEYED BY: MICHAEL STRAUB

CLOSURE: 0.00 : 10.000

MAP PAGE(S): 3-A, 3-B, 3-E, 3-F, 3-G

APPROVED BY: JAH DATE: 5-8-03

SCALE: 1" = 100' PRIOR INSTRUMENT: ADD TO DUP