

RASTER

PARENT PARCEL: 02-02-001-101-030

CHILD PARCEL:


STARTING POINT: INTERSECTION OF C/L OF KOLBE RD. AND SOUTHEAST CORNER OF HOLL-DAR SUB. (VOL.15 PG.74)

NO. 00886-A


1 OF 3



HOLL-DAR SUB.  
VOL.15 PG.74

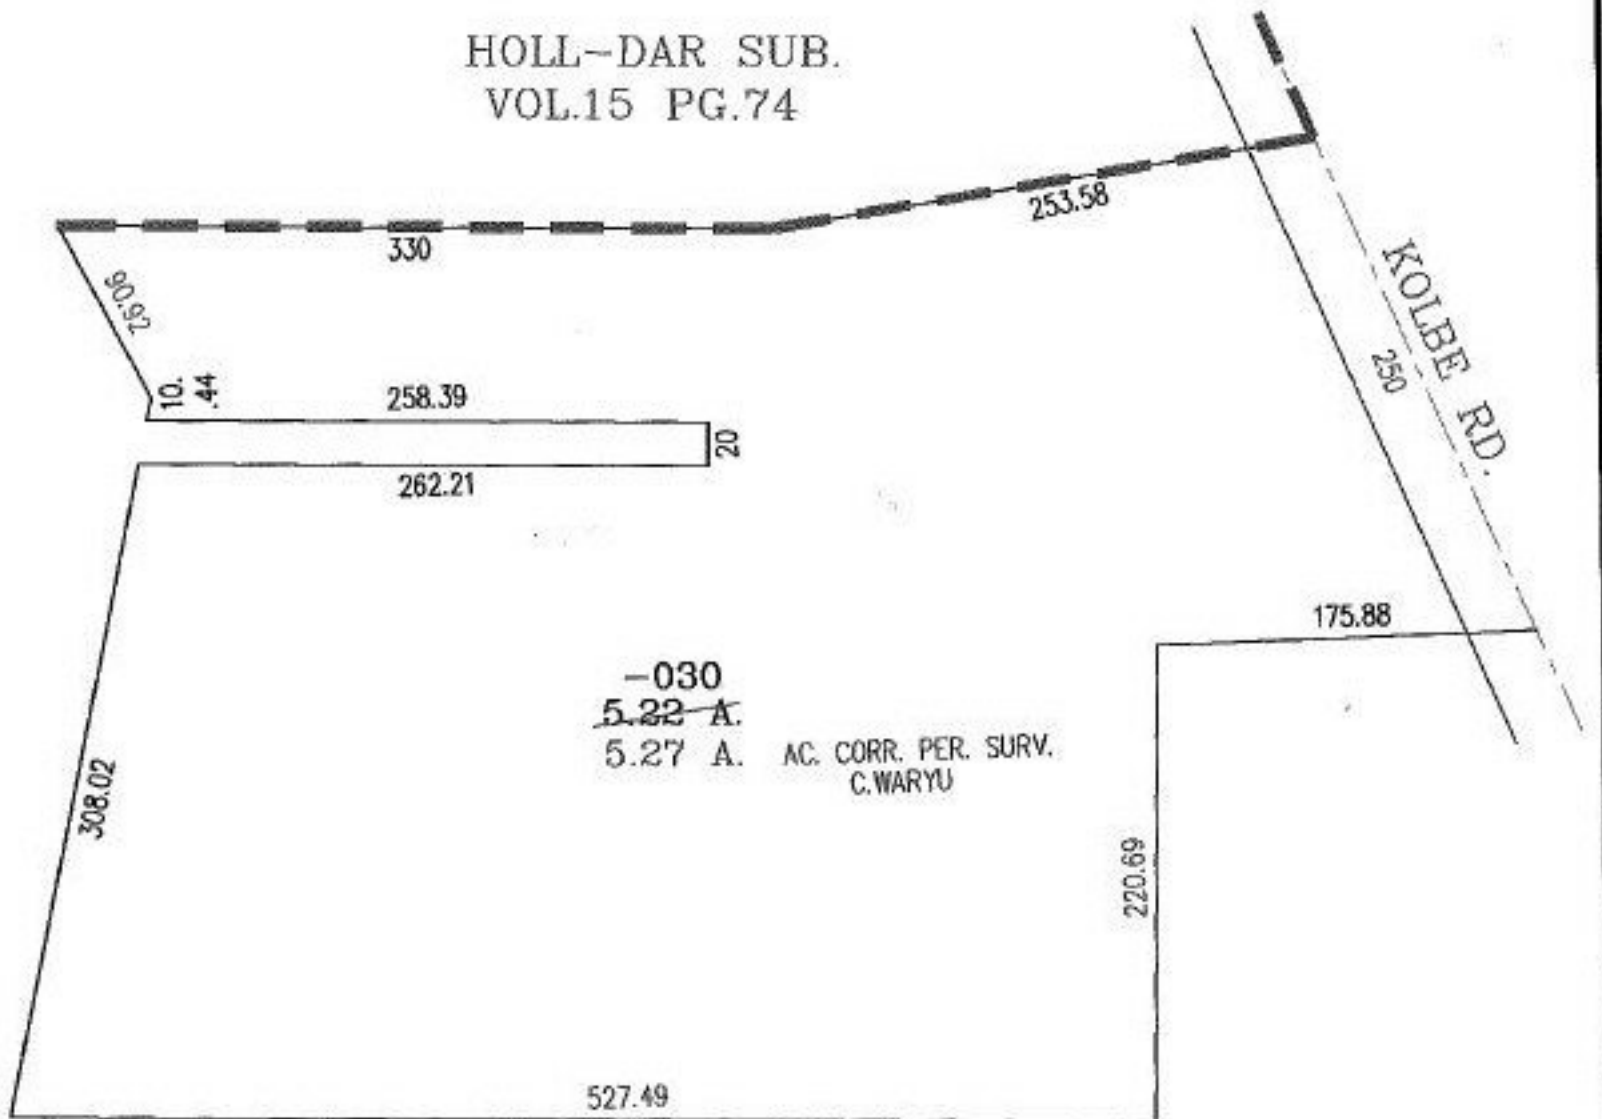

-030  
~~5.22~~ A.  
5.27 A. AC. CORR. PER. SURV.  
C. WARYU

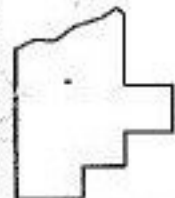

SPLITS/DEEDS PROCESSED

LORAIN COUNTY TAX MAP DEPARTMENT  
226 MIDDLE AVE. ELYRIA, OHIO

SURVEYED BY:	CHARLES WARYU
CLOSURE:	02:10.000
MAP PAGE(S):	02-02-001-A
APPROVED BY:	RRM DATE: 11-13-03
SCALE:	1" = 100' PRIOR INSTRUMENT: