


PARENT PARCEL: 08-00-103-000-020

CHILD PARCEL: --SAME--

STARTING POINT: INT BAUMHART RD AND S LINE OF O.L. 103

NO. 00938-A

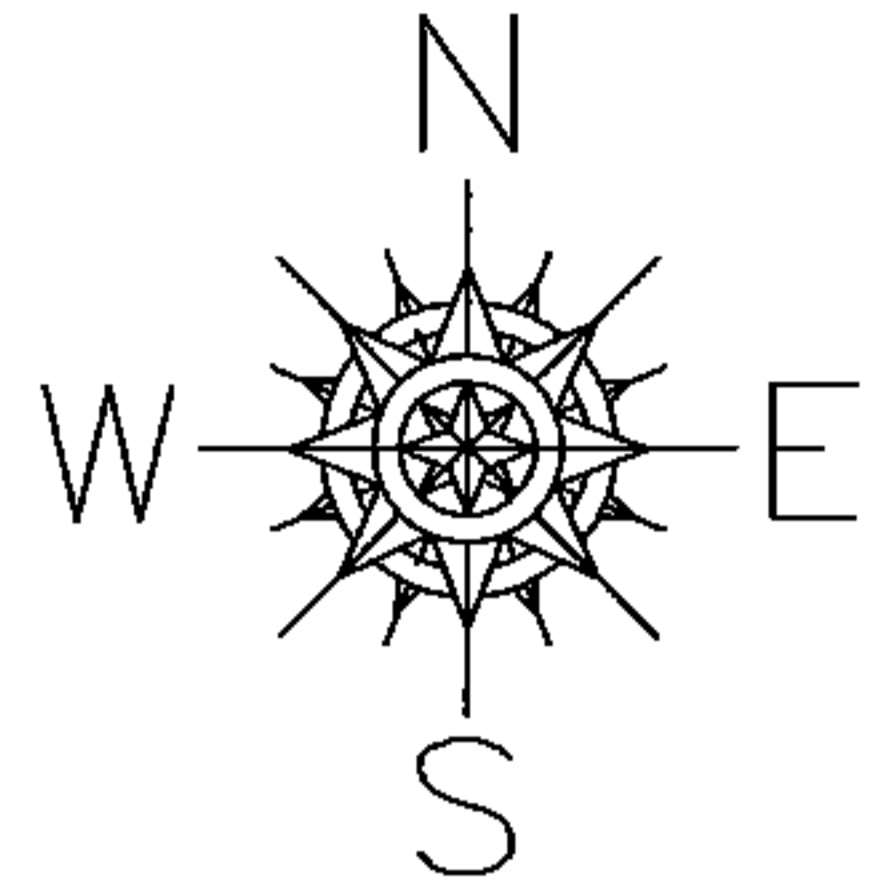

BAUMHART RD

L=251.41'
R=2321.83

376.71

303.08

-020

~~3.34 A.~~

3.00 A.

444.96

AC. CORR.
PER SURVEY
SCOTT J. CASEY

30


301.87

100'00"

O.L.103

O.L.104

O.L. 5

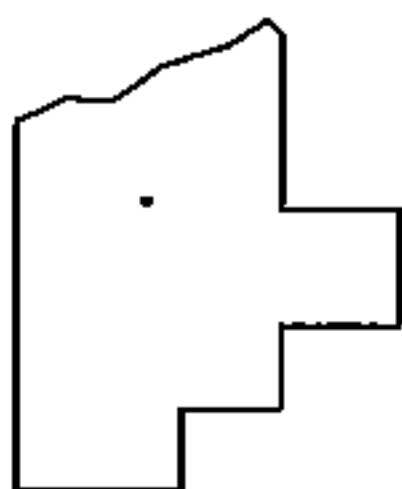

SPLITS/DEEDS PROCESSED

LORAIN COUNTY TAX MAP DEPARTMENT
226 MIDDLE AVE. ELYRIA, OHIO

SURVEYED BY: SCOTT CASEY

CLOSURE: 1:10.000

MAP PAGE(S): 08-D

APPROVED BY: DRH DATE: 11/7/2003

SCALE: 1"=100 PRIOR INSTRUMENT: 20020805246