

MASTER

PARENT PARCEL: 05-00-047-000-008


CHILD PARCEL: 05-00-047-000-020, -021

STARTING POINT: INT S LINE O.L. 47 INT OBERLIN RD

NO. 00949-C



SPLIT STRAIGHT
TRANSFERRED IN 1980
ADD TO DUP 12/9/2003

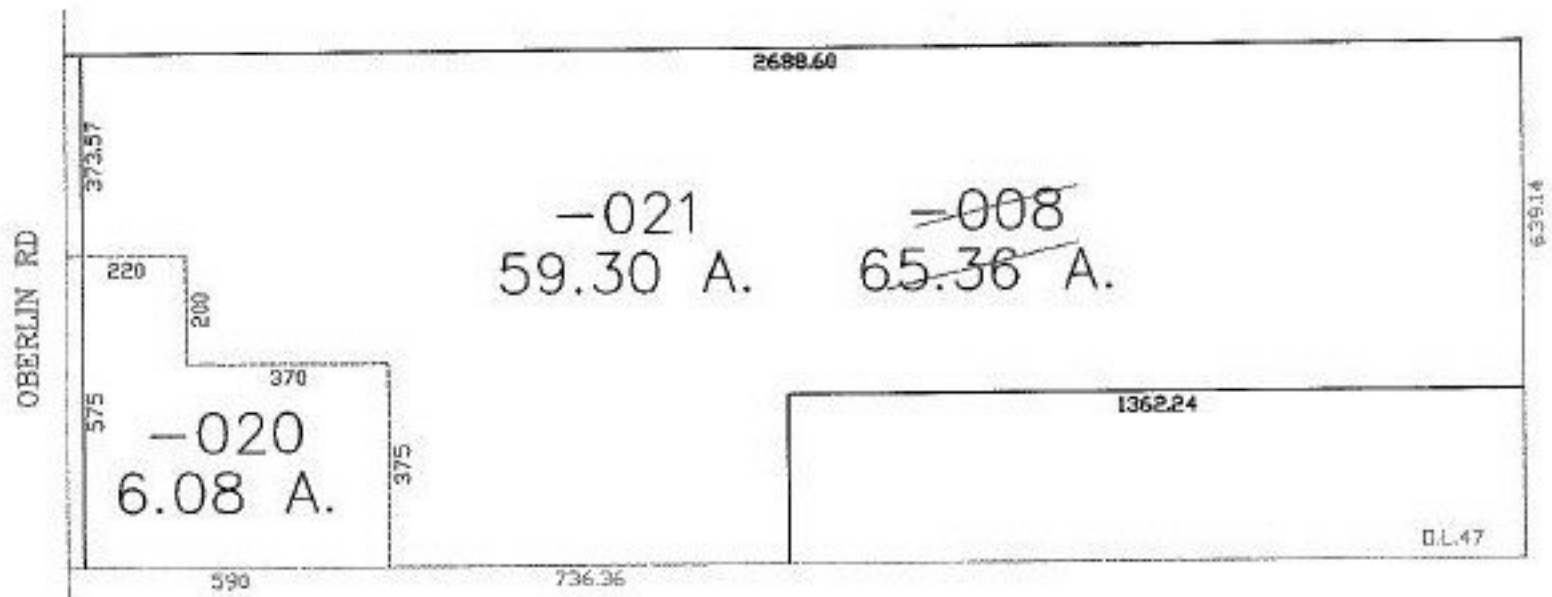

SPLITS/DEEDS PROCESSED
LORAIN COUNTY TAX MAP DEPARTMENT
226 MIDDLE AVE. ELYRIA, OHIO

SURVEYED BY: N/A
CLOSURE: 1:10,000
MAP PAGE(S): 5-6
APPROVED BY: DRH DATE: 12/9/2003
SCALE: 1" = 400' PRIOR INSTRUMENT: DV 1515/130