


MASTER

PARENT PARCEL: 11-00-072-000-008, -020

CHILD PARCEL: --SAME--

STARTING POINT:

NO. 00951-A

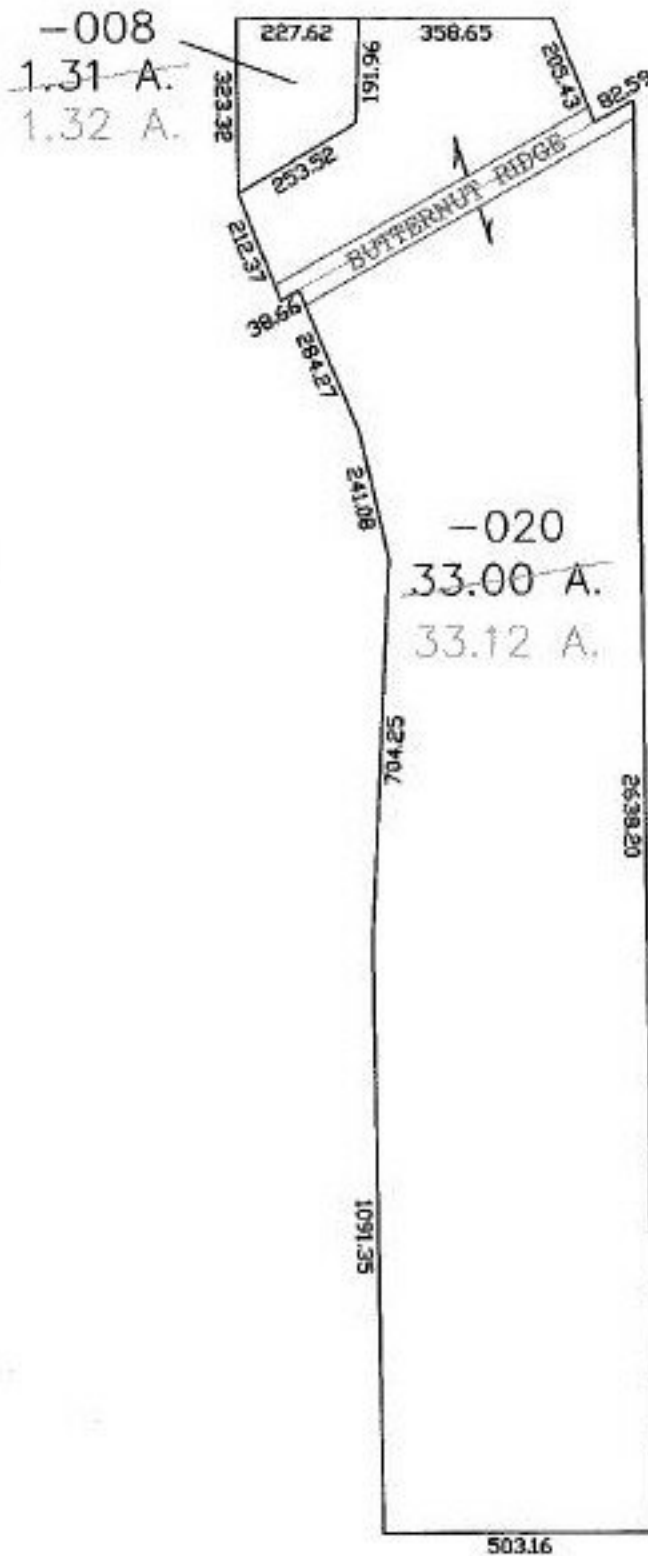

1 of 2



SPLITS/DEEDS PROCESSED
LORAIN COUNTY TAX MAP DEPARTMENT
 226 MIDDLE AVE. ELYRIA, OHIO

SURVEYED BY: MARK YEAGER
 CLOSURE: 1:10,000
 MAP PAGE(S): 11-00-072-B
 APPROVED BY: DRH DATE: 12/3/2003
 SCALE: 1" = 400 PRIOR INSTRUMENT: OR. 1066/477