


RASTER

PARENT PARCEL: 06-24-014-000-030

CHILD PARCEL: 06-24-014-000-063, -064

STARTING POINT: CENTERLINE OF MURRAY RIDGE RD. & O.L. 14

NO. 01291

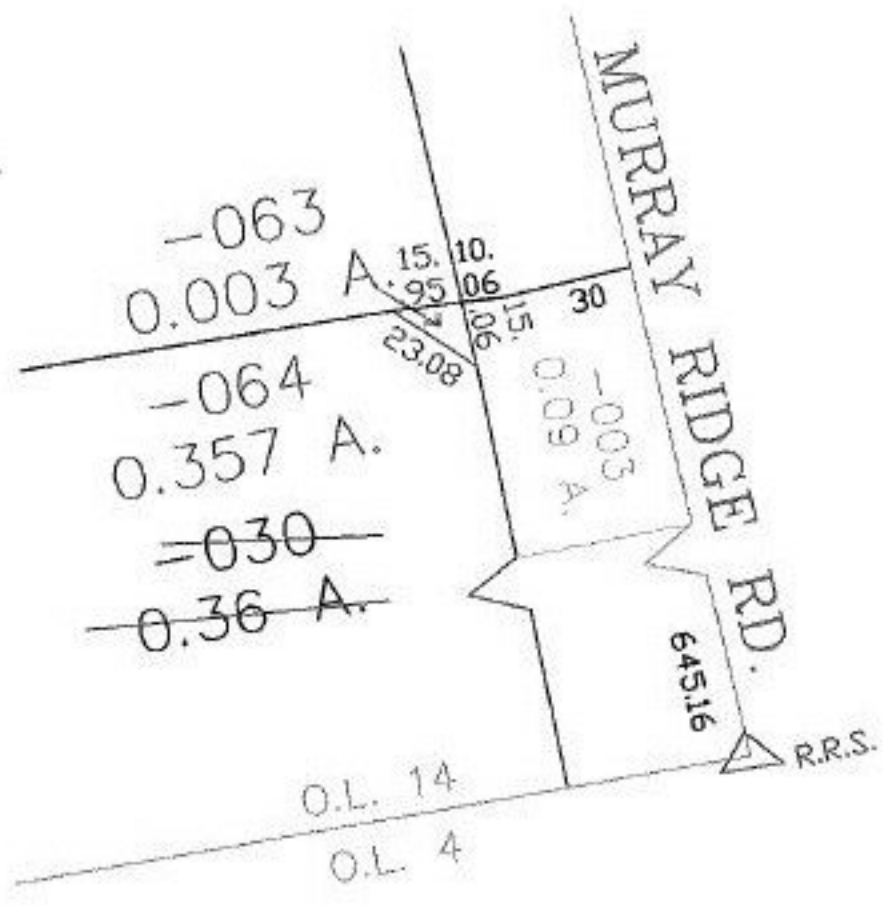

SPLITS/DEEDS PROCESSED
 LORAIN COUNTY TAX MAP DEPARTMENT
 226 MIDDLE AVE. ELYRIA, OHIO

SURVEYED BY: MARK A. YEAGER
 CLOSURE: 0.01 : 10.000
 MAP PAGE(S): 6-112
 APPROVED BY: JAH DATE: 1-16-03
 SCALE: 1" = 50' PRIOR INSTRUMENT: OR 807/640