


RASTER

PARENT PARCEL: 06-24-011-000-017

CHILD PARCEL: 06-24-011-000-021, -022

STARTING POINT: O.L. 99 & O.L. 100

NO. 01292

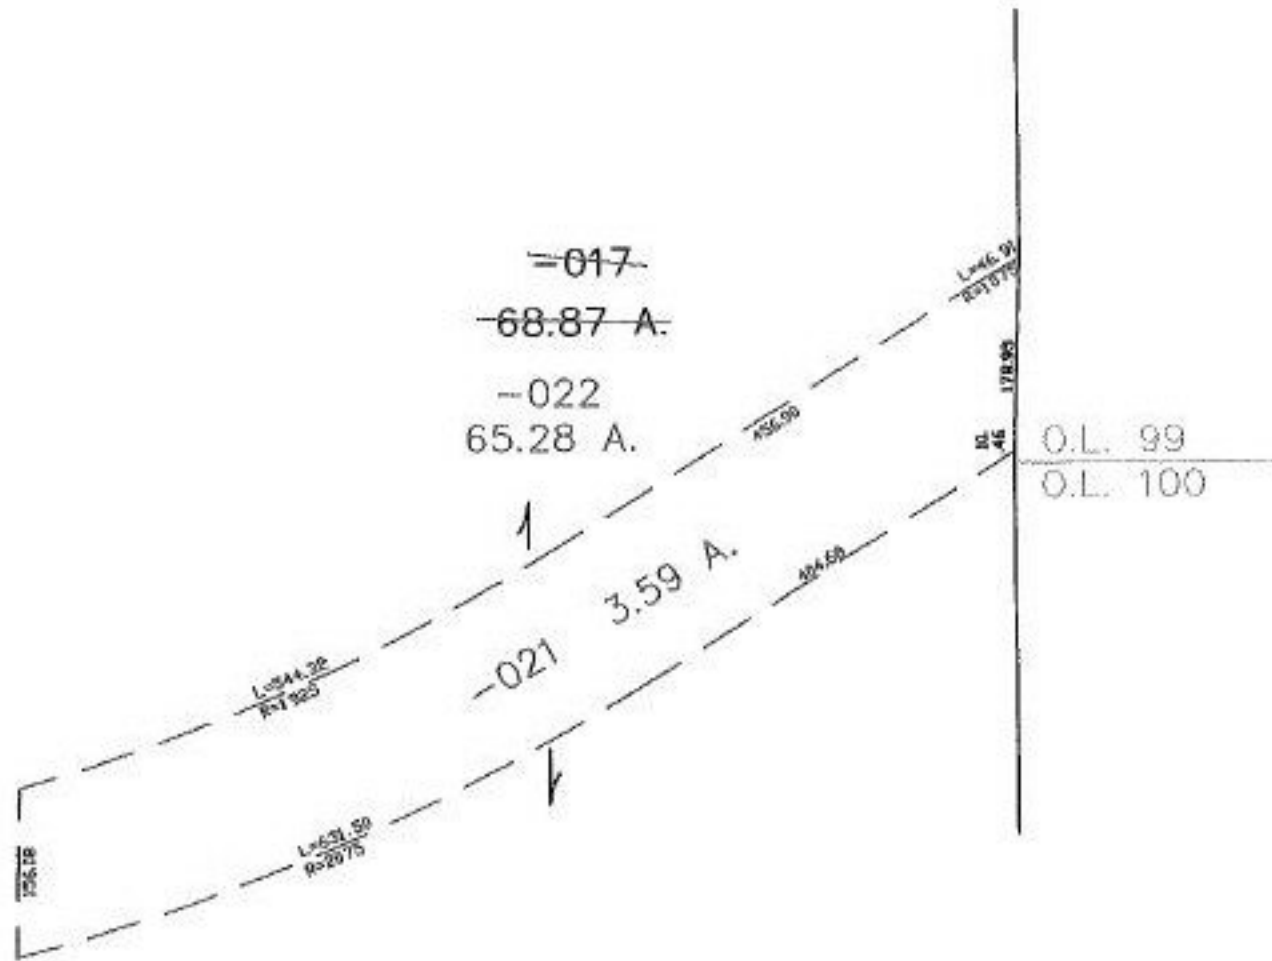

**SPLITS/DEEDS PROCESSED**  
 LORAIN COUNTY TAX MAP DEPARTMENT  
 226 MIDDLE AVE. ELYRIA, OHIO

SURVEYED BY: MARK A. YEAGER  
 CLOSURE: 0.00 ; 10.000  
 MAP PAGE(S): 06-115  
 APPROVED BY: JAH DATE: 1-24-03  
 SCALE: 1" = 200 PRIOR INSTRUMENT: DV 533/181