


RASTER

PARENT PARCEL: 18-00-008-000-030

CHILD PARCEL: 18-00-008-000-040, -041, -042

STARTING POINT: RR SPIKE INT OF C.L. HAWLEY RD AND PECK WADSWORTH RD

NO. 01299

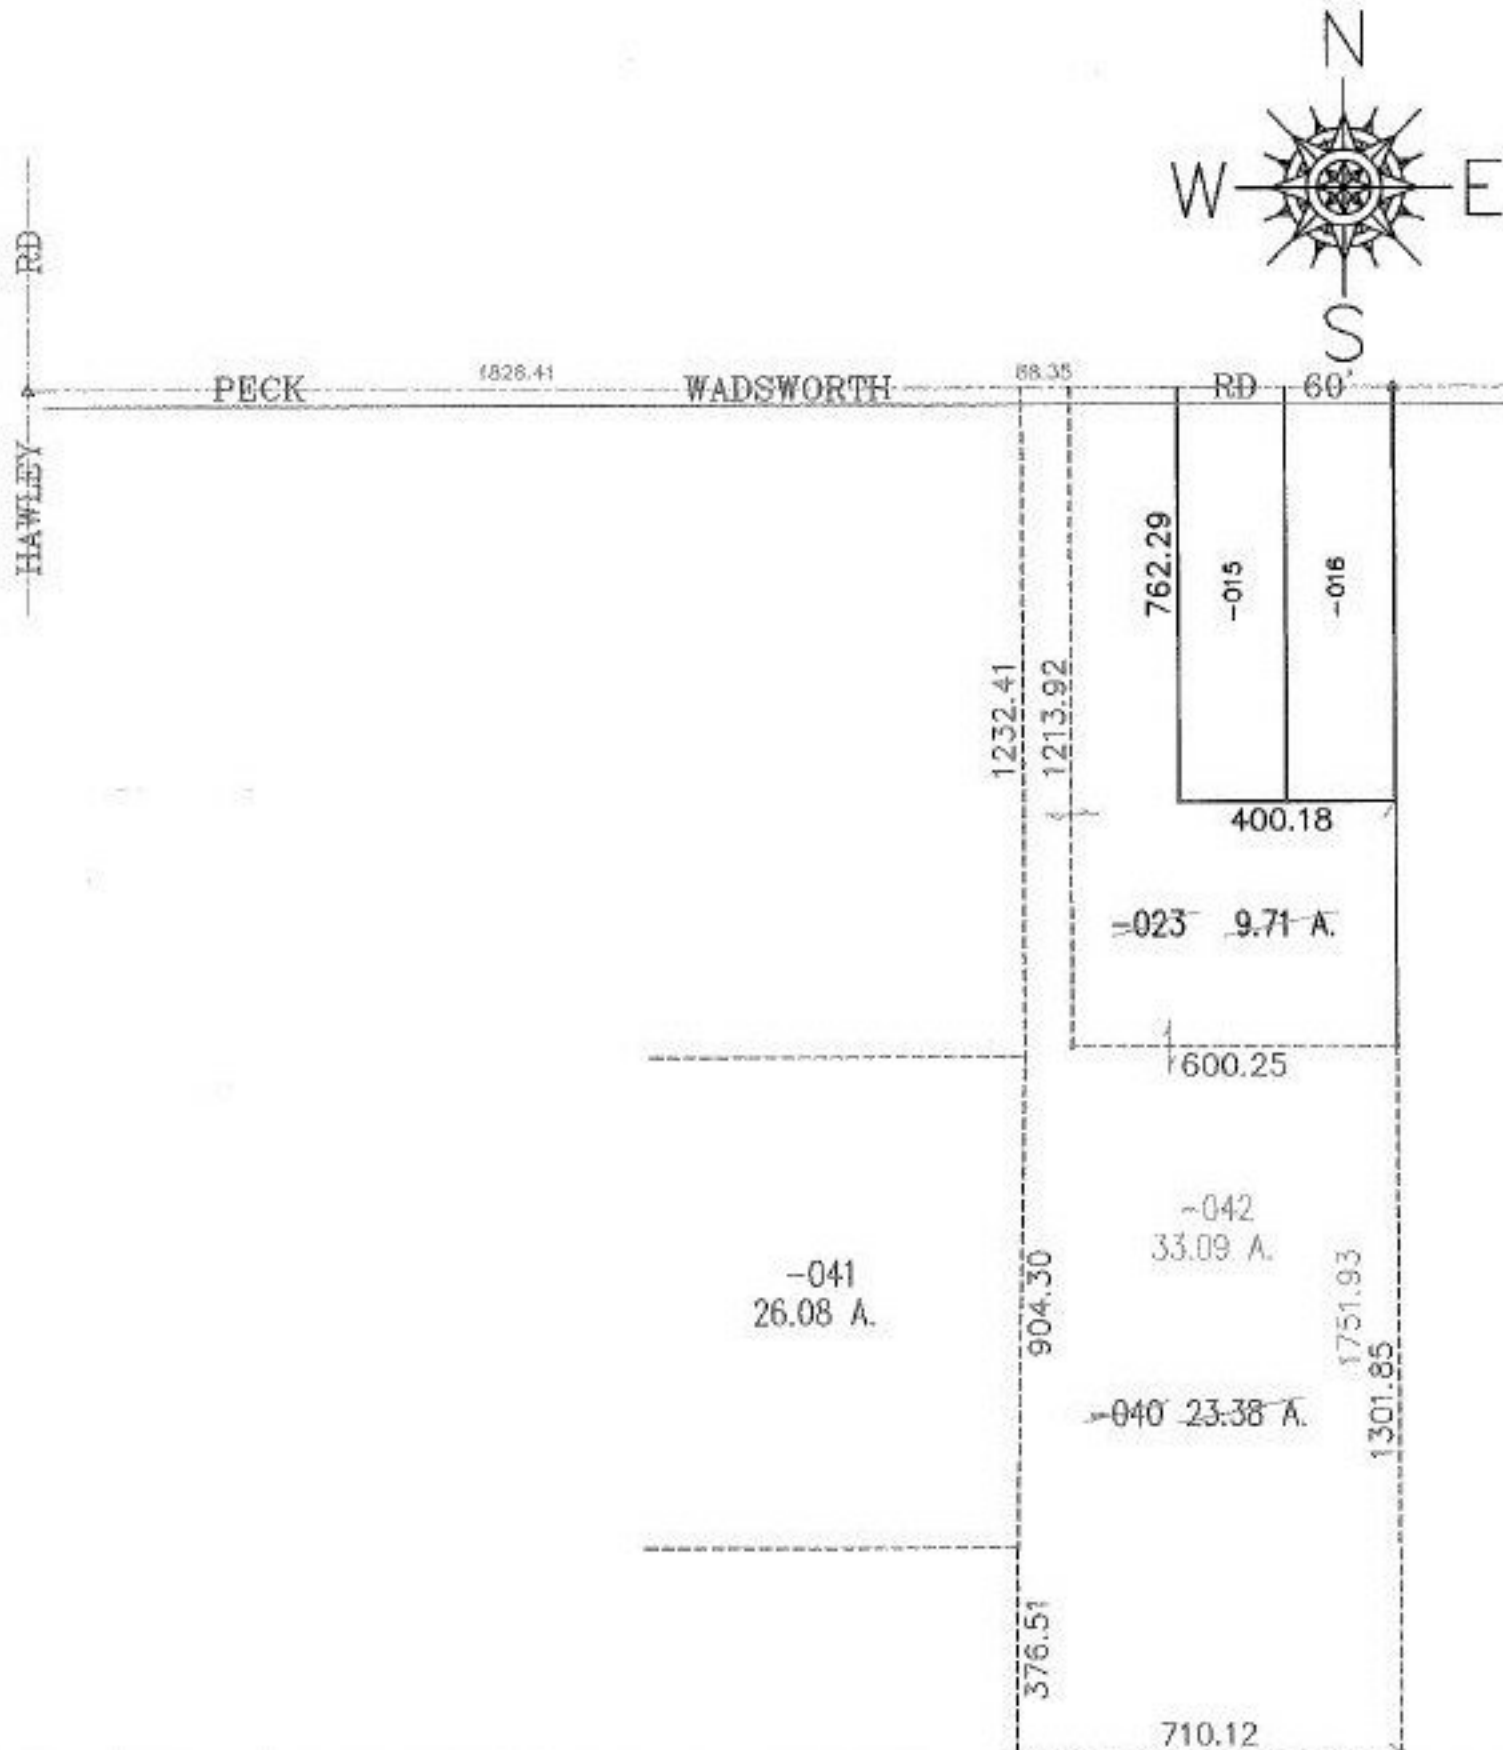

SPLITS/DEEDS PROCESSED
LORAIN COUNTY TAX MAP DEPARTMENT
 226 MIDDLE AVE. ELYRIA, OHIO

SURVEYED BY: RICHARD D. CARLSON
 CLOSURE: N/A
 MAP PAGE(S): 18-00-018-D
 APPROVED BY: DRH DATE: 2/3/03
 SCALE: 1" = 400' PRIOR INSTRUMENT: 20000701693