

PARENT PARCEL: 03-00-088-101-017, 03-00-084-000-015


CHILD PARCEL: 03-00-084-000-017 THRU -019 03-00-088-101-018

STARTING POINT: CENTERLINE OF GROVE AVE. & EAST 28TH ST.

NO. 01300



~~03-00-088-101-017~~ ~~03-00-088-101-018~~
~~537.15 A.~~ ~~497.53 A.~~
03-00-088-101-019
192.36 A.

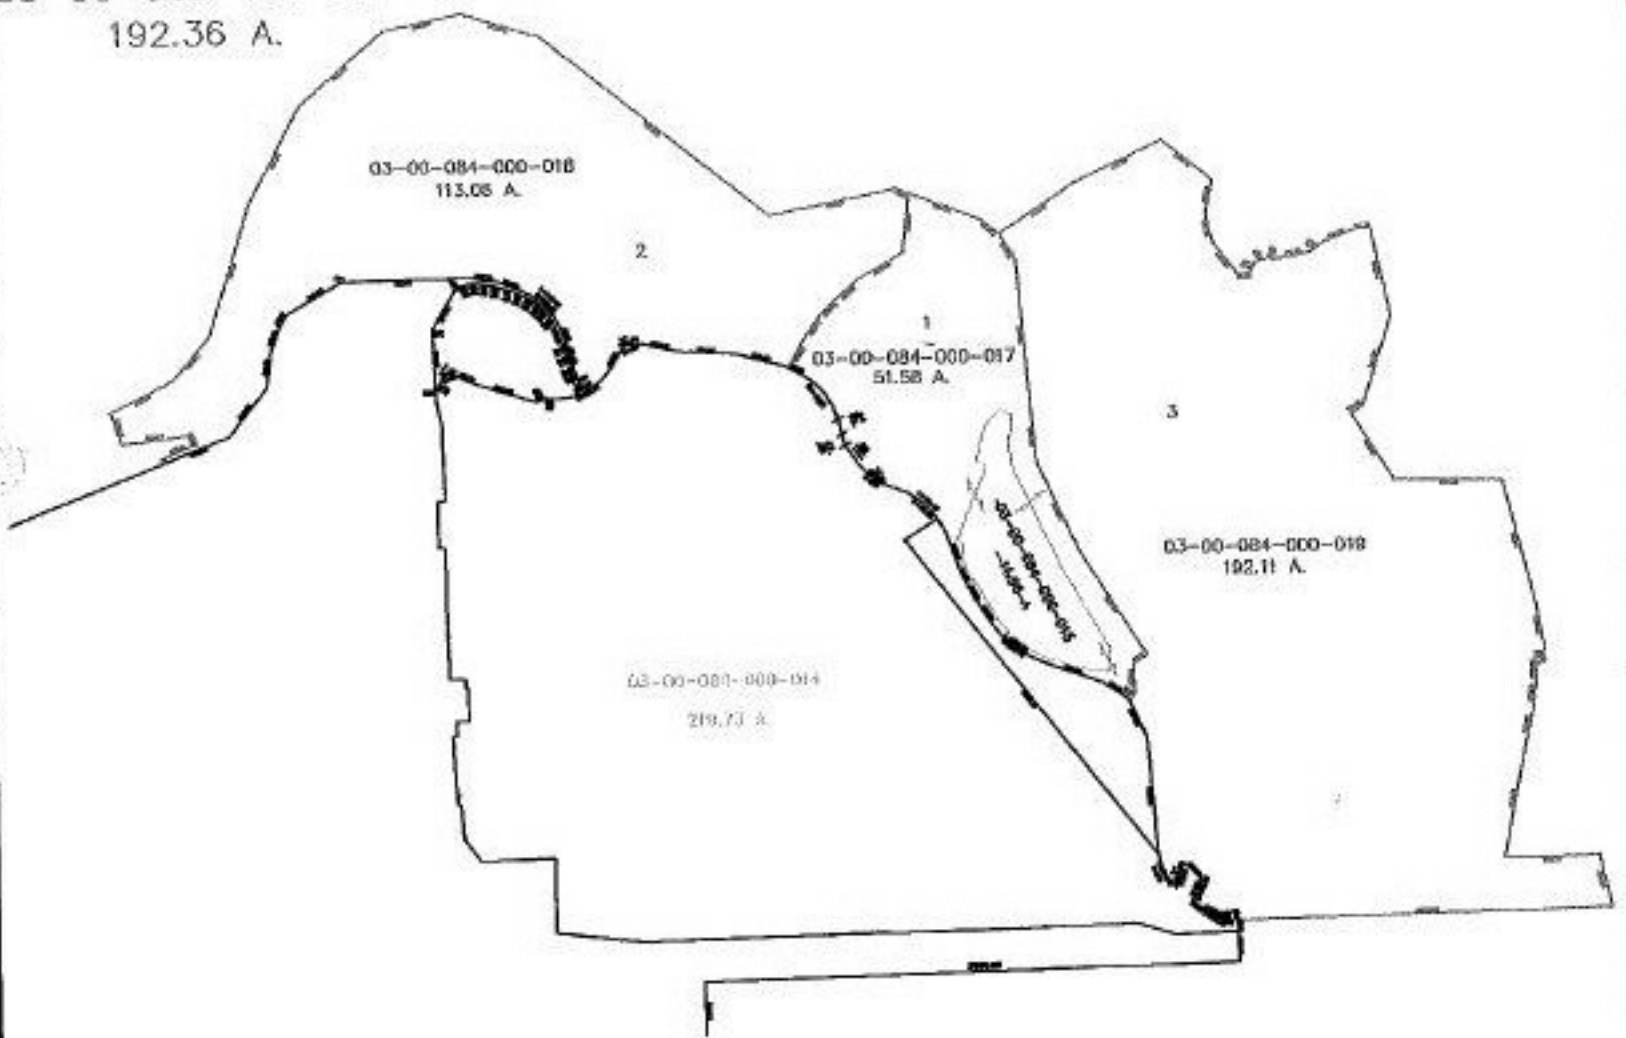

SPLITS/DEEDS PROCESSED
LORAIN COUNTY TAX MAP DEPARTMENT
226 MIDDLE AVE. ELYRIA, OHIO

SURVEYED BY: MICHAEL STRAUB
CLOSURE: 0.00 : 10.000
MAP PAGE(S): 3-E, 3-F
APPROVED BY: JAH DATE: 3-11-02
SCALE: 1" = 1200 PRIOR INSTRUMENT: 20020850503