
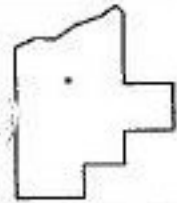


PARENT PARCEL: 03-00-011-101-013, 03-00-073-000-066

CHILD PARCEL: 03-00-011-101-014, -015 & 03-00-073-000-067, -068

STARTING POINT: CENTERLINE OF NORTH RIDGE RD. & O.L. 73

NO. 01302

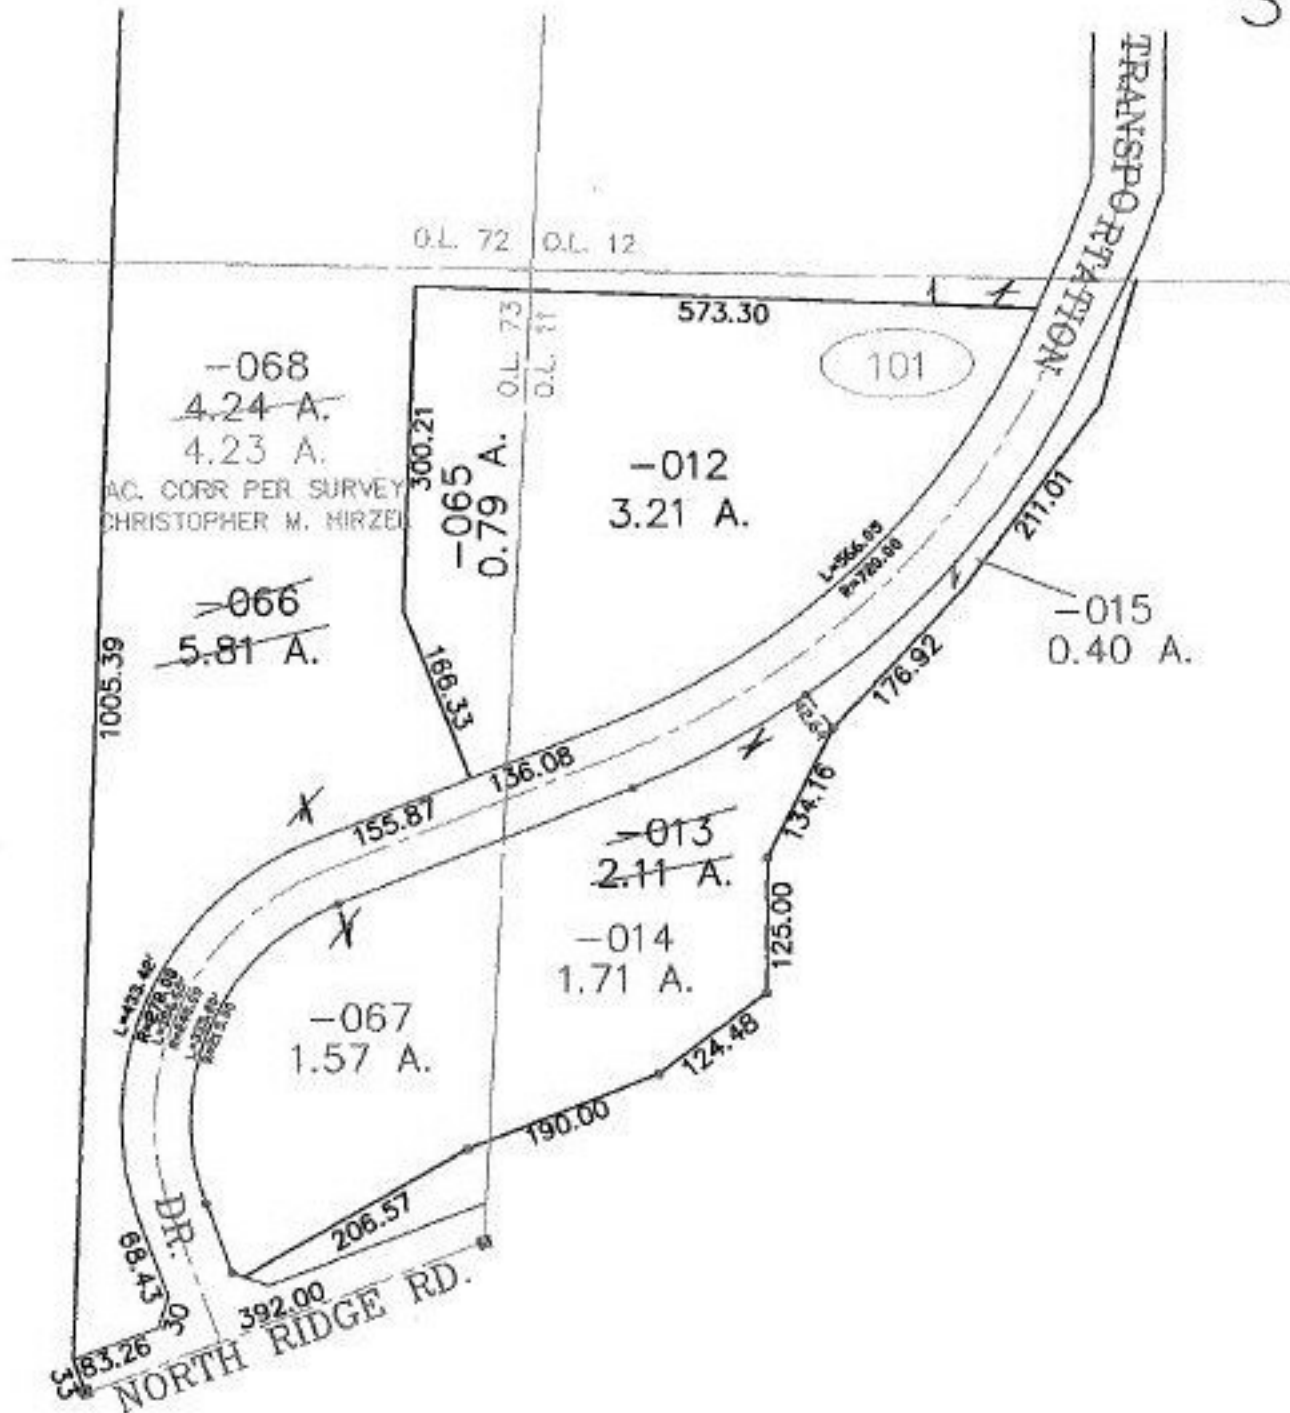

SPLITS/DEEDS PROCESSED
LORAIN COUNTY TAX MAP DEPARTMENT
 226 MIDDLE AVE. ELYRIA, OHIO

SURVEYED BY: CHRISTOPHER M. HIRZEL

CLOSURE: 0.00 : 10.000

MAP PAGE(S): 03-00-011-A, 03-00-073-B

APPROVED BY: DRH DATE: 2-4-03

SCALE: 1" = 200' PRIOR INSTRUMENT: 19990593447