


PARENT PARCEL: 03-00-011-102-119

CHILD PARCEL: 03-00-011-102-120, -121

STARTING POINT: INT C.L. ABBE RD AND SOUTHERLY LINE OF O.L. 11

NO. 01304

ALSO SEE PINK TICKET #03-00809-C FOR MAP CORR. TO PARCEL -116

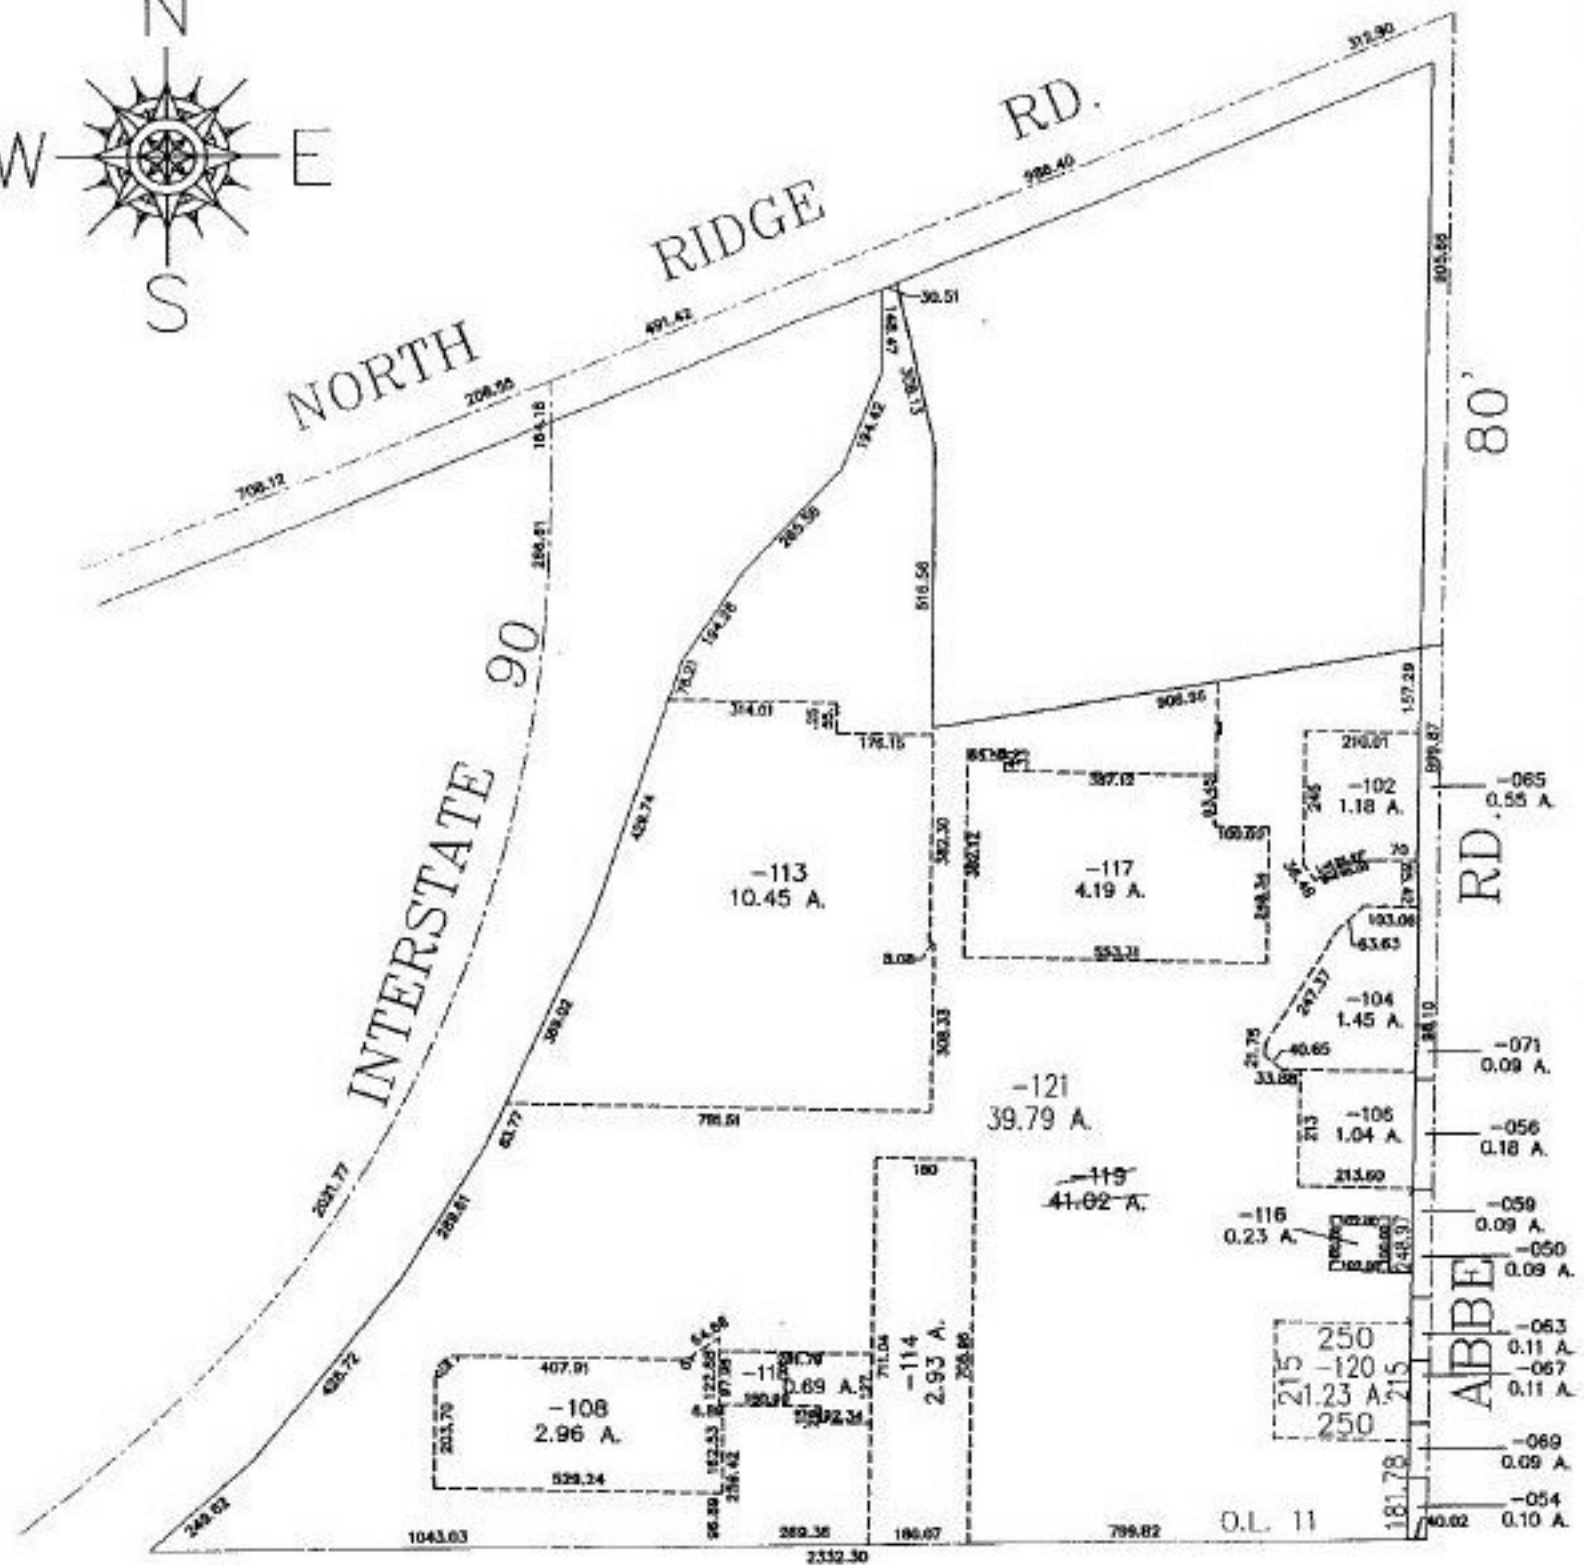

**SPLITS/DEEDS PROCESSED**  
**LORAIN COUNTY TAX MAP DEPARTMENT**  
 226 MIDDLE AVE. ELYRIA, OHIO

SURVEYED BY: TERIN J. KAMINSKI  
 CLOSURE: 0:00/10.000  
 MAP PAGE(S): 03-00-011-A  
 APPROVED BY: RRM DATE: 2/5/03  
 SCALE: 1" = 400' PRIOR INSTRUMENT: 2001742542