


NO. 01305

PARENT PARCEL: 03-00-055-121-017  
CHILD PARCEL: 03-00-055-121-026, -027, -028  
STARTING POINT: INT. WEST LINE O.L. 55 AND C.L. OF 611  
INT. EAST LINE O.L. 55 AND C.L. OF 611



MISSOURI 50'

COLORADO AVE 60'

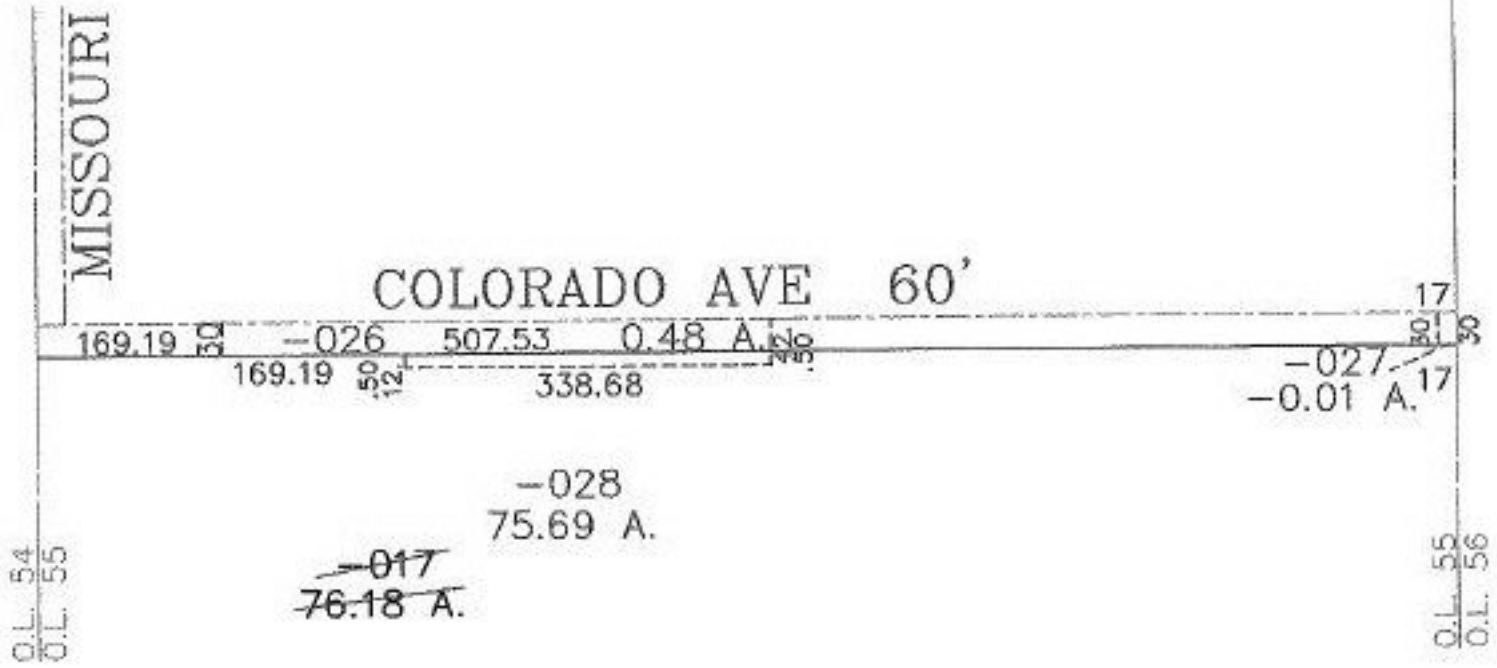

PRIOR INSTRUMENT: O.R. 19/466  
PRIOR INSTRUMENT: D.V. 908/26  
PRIOR INSTRUMENT: D.V. 724/162

SURVEYED BY: K.E. McARTNEY & ASSOC.  
CLOSURE: 0:00:10.000  
MAP PAGE(S): 3-A, 03-00-055-A  
APPROVED BY: DRH DATE: 2/18/03  
SCALE: 1" = 200'



**SPLITS/DEEDS PROCESSED**  
LORAIN COUNTY TAX MAP DEPARTMENT  
226 MIDDLE AVE. ELYRIA, OHIO