

PARENT PARCEL: 02-00-051-144-004, 02-00-051-144-006

CHILD PARCEL: 02-00-051-144-008, -009, -010


STARTING POINT: INT E LINE O.L. 51 & C.L. 611

NO. 01306



COLORADO AVE 60'

HENDERSON DR.

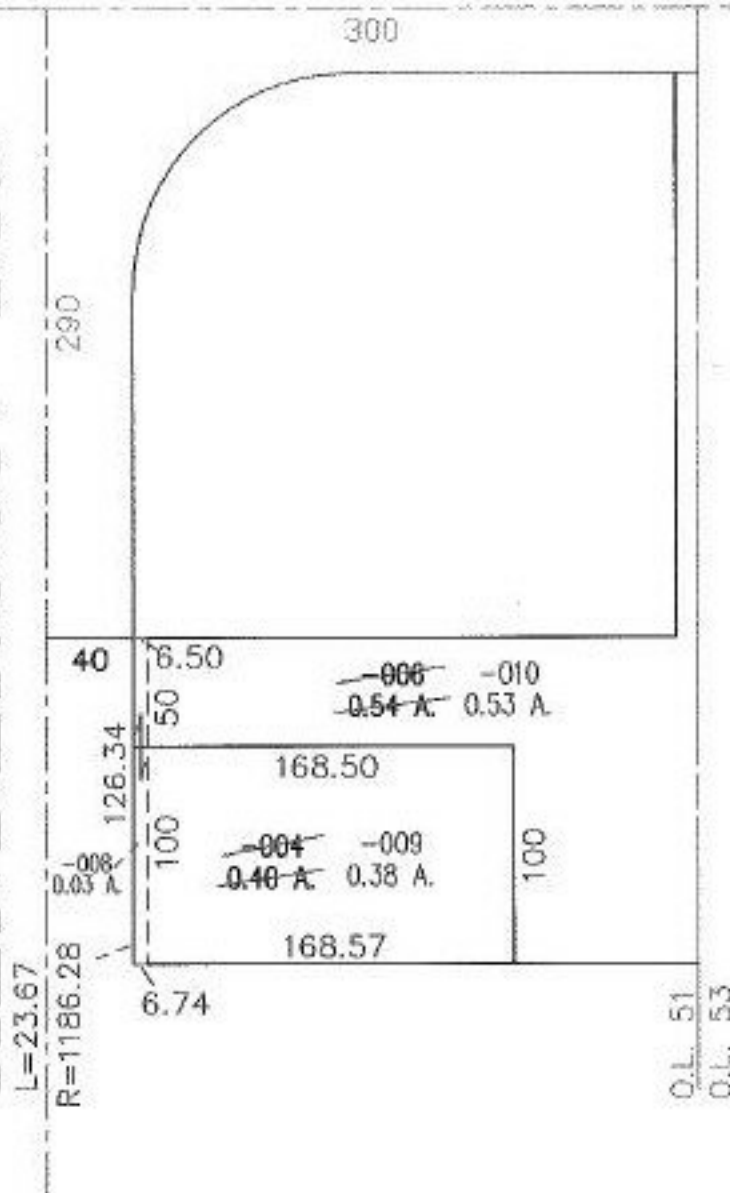

PRIOR INSTRUMENT: 990636066

PRIOR INSTRUMENT: 990635995



SPLITS/DEEDS PROCESSED
LORAIN COUNTY TAX MAP DEPARTMENT
 226 MIDDLE AVE. ELYRIA, OHIO

SURVEYED BY: K.E. McARTNEY & ASSOC.

CLOSURE: 0.31:10.000

MAP PAGE(S): 02-00-051-B

APPROVED BY: DRH DATE: 2/18/03

SCALE: 1" = 100'