


RASTER

PARENT PARCEL: 06-24-014-000-039, -040, -041

CHILD PARCEL: 06-24-014-000-065 THRU -071 06-24-015-000-056

STARTING POINT: CENTERLINE OF MURRAY RIDGE RD. & O.L. 14

NO. 01323

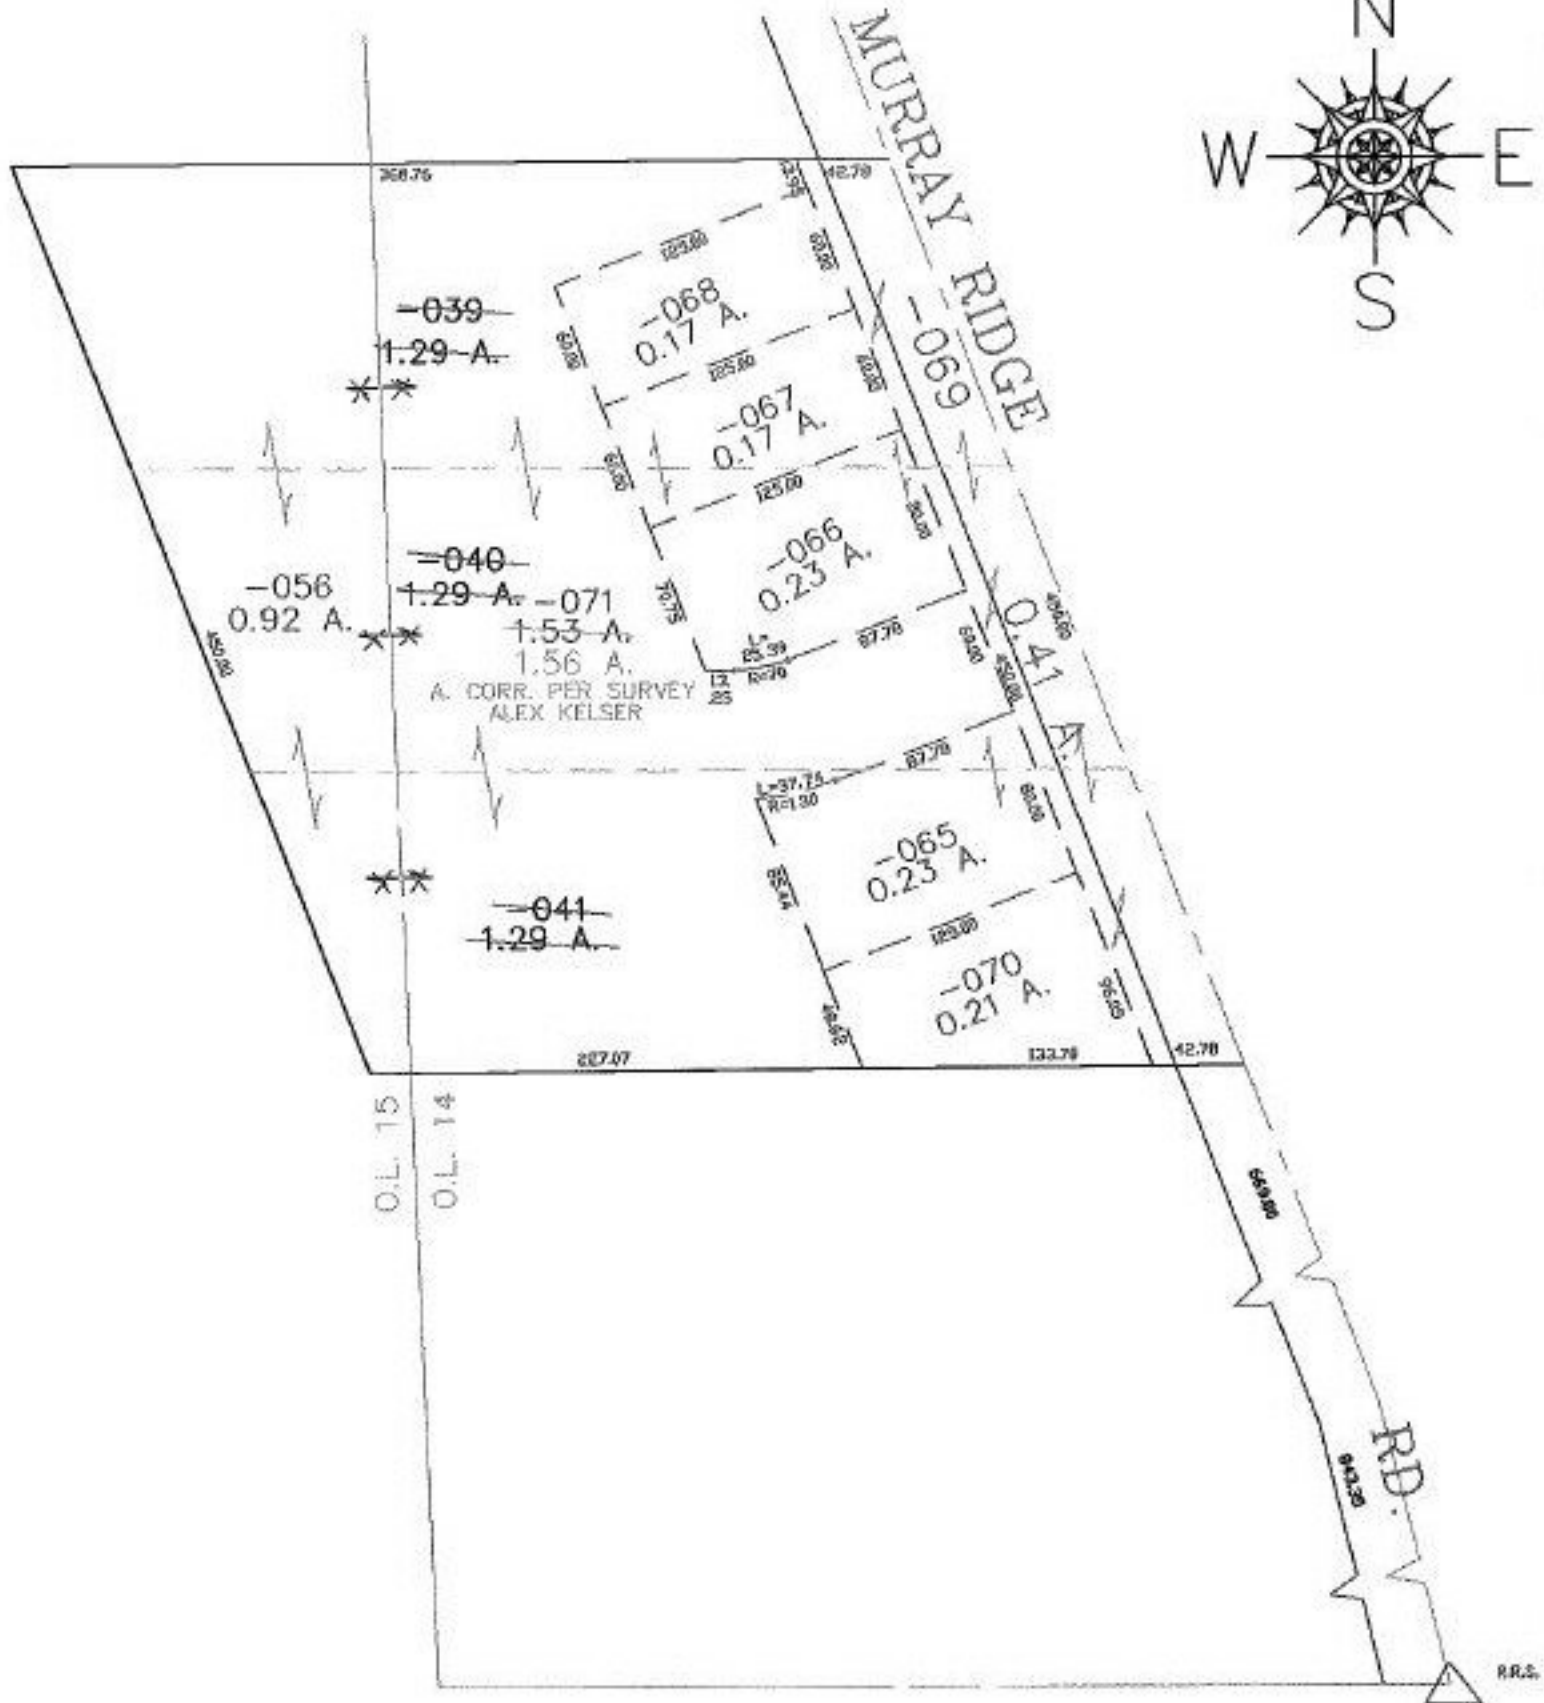

SPLITS/DEEDS PROCESSED

LORAIN COUNTY TAX MAP DEPARTMENT
226 MIDDLE AVE. ELYRIA, OHIO

SURVEYED BY: ALEX KELSER

CLOSURE: 0.00 : 10.000

MAP PAGE(S): 6-94

APPROVED BY: JAH DATE: 3-10-03

SCALE: 1" = 100' PRIOR INSTRUMENT: 20020857851