


MASTER

PARENT PARCEL: 04-00-029-000-075  
CHILD PARCEL: 04-00-029-000-548, -549  
STARTING POINT: CENTERLINE OF LEAR RD. & WALKER RD.

NO. 01325

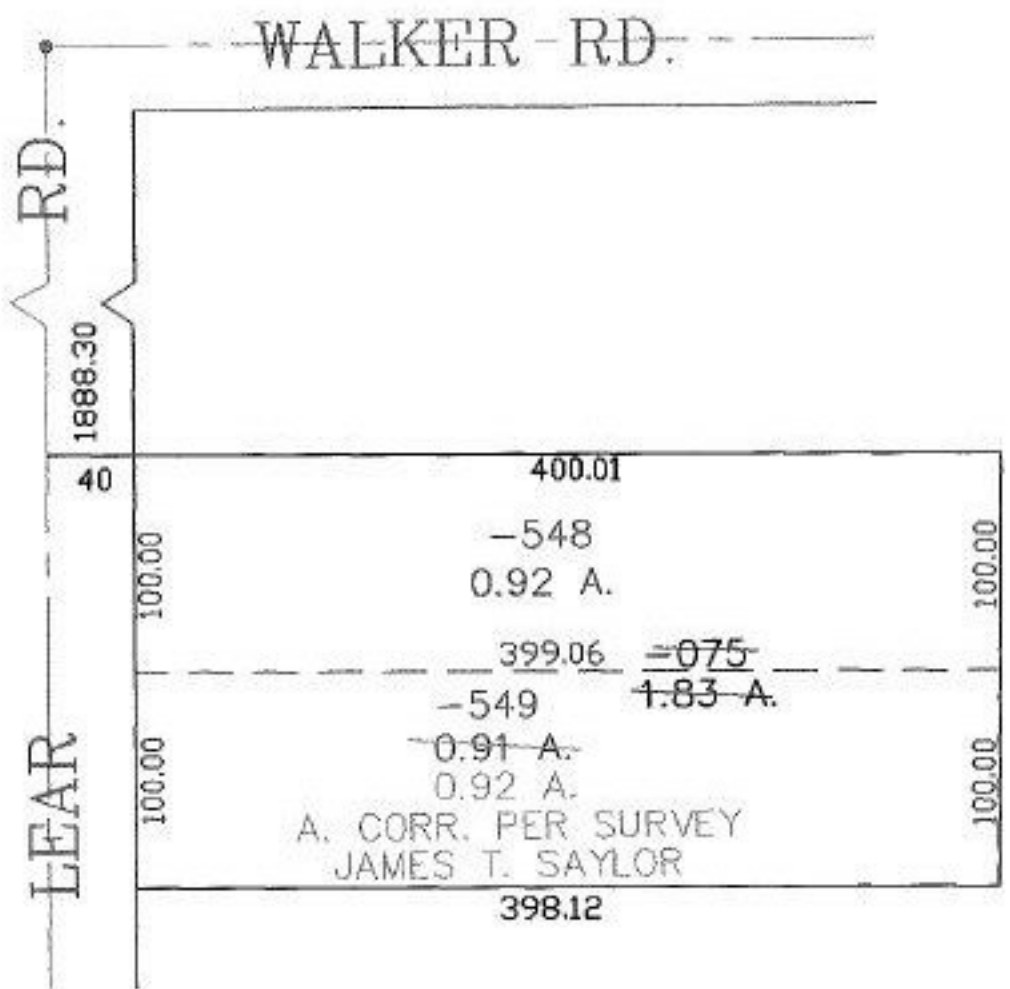

**SPLITS/DEEDS PROCESSED**  
LORAIN COUNTY TAX MAP DEPARTMENT  
226 MIDDLE AVE. ELYRIA, OHIO

SURVEYED BY: JAMES T. SAYLOR  
CLOSURE: 0.00 : 10.000  
MAP PAGE(S): 04-00-029-A  
APPROVED BY: JAH DATE: 3-12-03  
SCALE: 1" = 100' PRIOR INSTRUMENT: 20030884648