
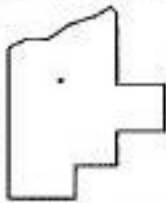


PARENT PARCEL: 03-00-073-000-068

CHILD PARCEL: 03-00-073-000-069, -070, -071

STARTING POINT: MON BOX INT CL NORTH RIDGE ROAD AND E LINE OF SL 73

NO. 01332

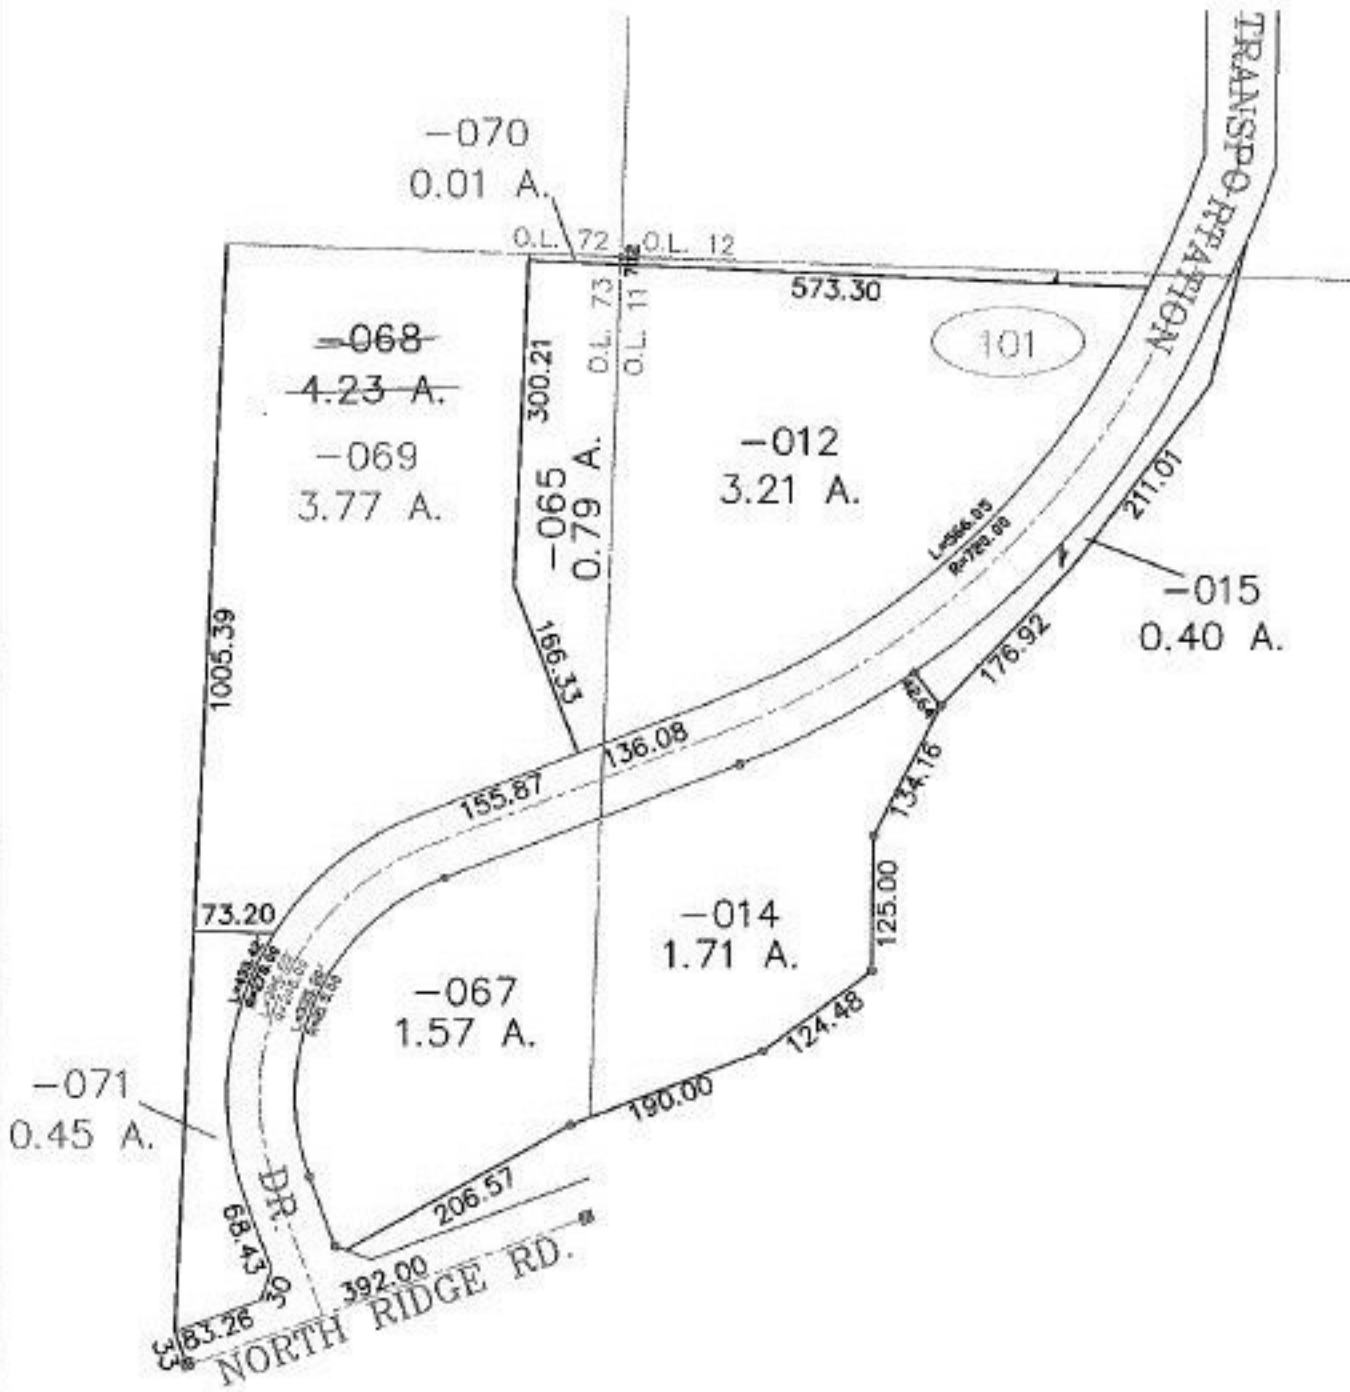

SPLITS/DEEDS PROCESSED
 LORAIN COUNTY TAX MAP DEPARTMENT
 226 MIDDLE AVE. ELYRIA, OHIO

SURVEYED BY: CHRISTOPHER HIRZEL
 CLOSURE: 0:00
 MAP PAGE(S): 03-00-073-B
 APPROVED BY: DRH DATE: 3/25/2003
 SCALE: 1" = 200' PRIOR INSTRUMENT: DV