



PARENT PARCEL: 01-00-004-104-013, -012, -014, -015  
CHILD PARCEL: 01-00-004-104-046 THRU -048  
STARTING POINT: SIDELINE OF EDGEWATER DR. & EAST LINE OF SUNNYSIDE BEACH ALLOT.

NO. 01337

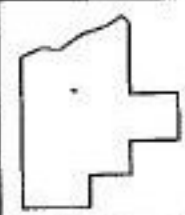

SUNNYSIDE BEACH ALLOT.  
VOL 9 PG 17

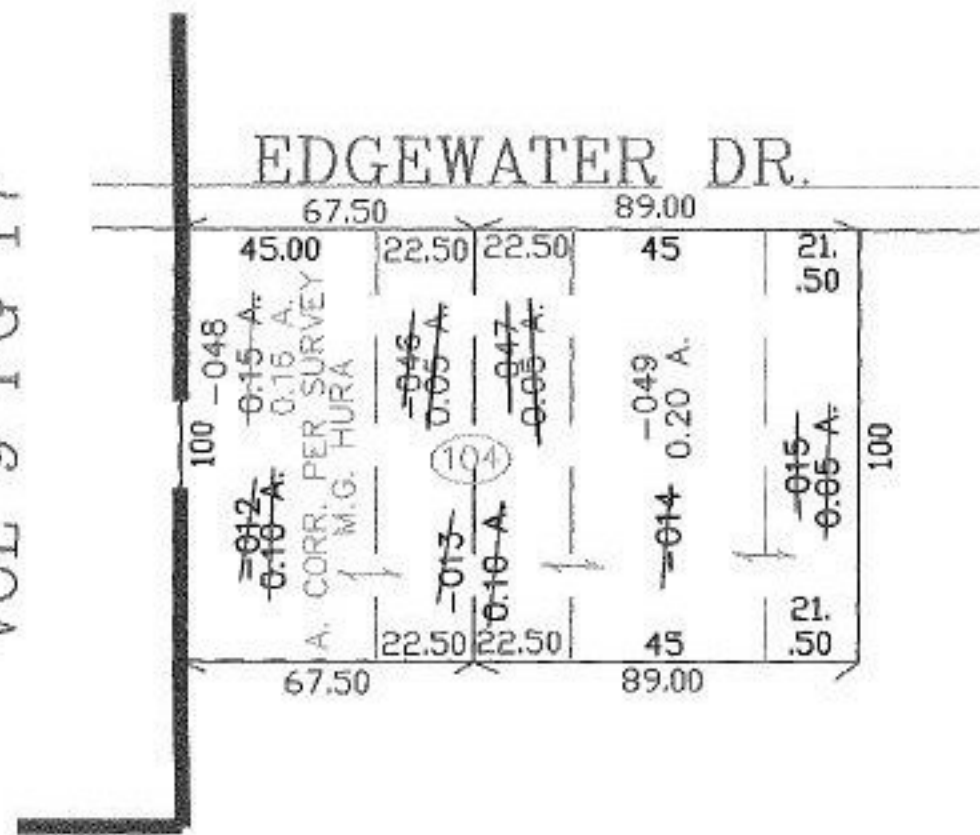

**SPLITS/DEEDS PROCESSED**  
LORAIN COUNTY TAX MAP DEPARTMENT  
226 MIDDLE AVE. ELYRIA, OHIO

SURVEYED BY: M.G. HURA  
CLOSURE: 0.00 : 10.000  
MAP PAGE(S): 01-00-004-A  
APPROVED BY: JAH DATE: 3-27-03  
SCALE: 1" = 50' PRIOR INSTRUMENT: OR 126/783