


RASTER

PARENT PARCEL: 07-00-024-101-082, -081
CHILD PARCEL: 07-00-024-101-107 THRU -109
STARTING POINT: CENTERLINE OF BUTTERNUT RIDGE RD. & WOOSTER AVON LAKE RD.

NO. 01344

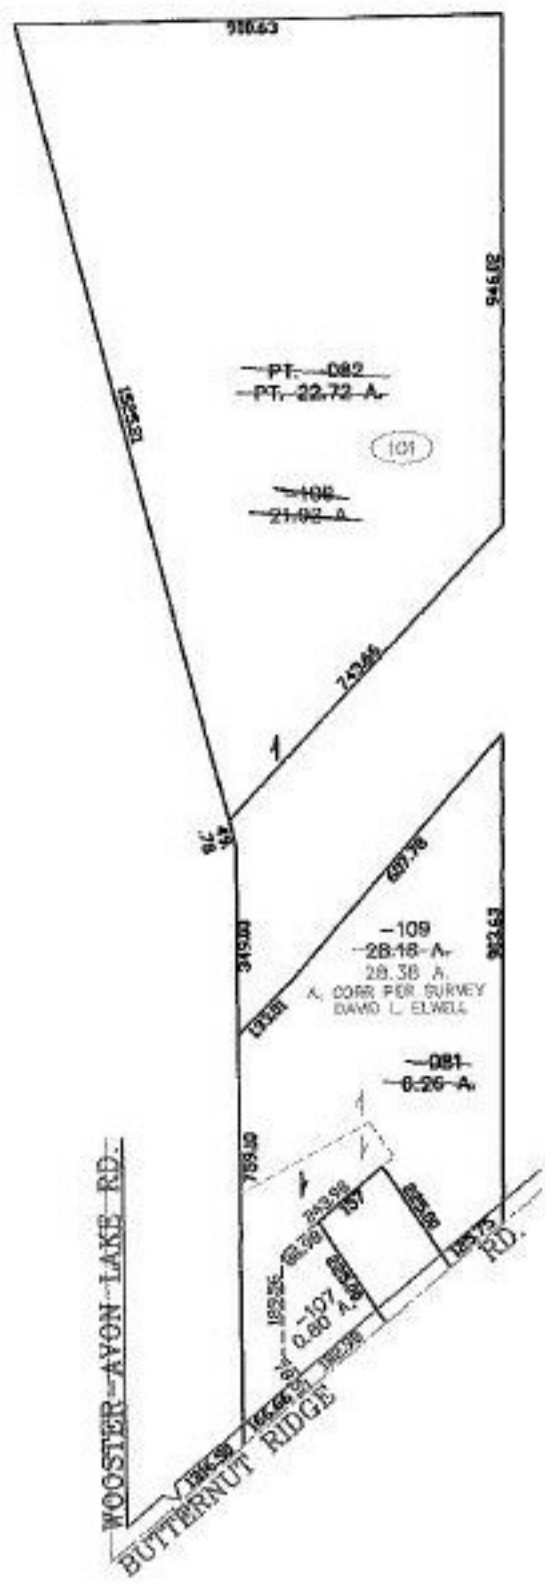

SPLITS/DEEDS PROCESSED
LORAIN COUNTY TAX MAP DEPARTMENT
226 MIDDLE AVE. ELYRIA, OHIO

SURVEYED BY: DAVID L. ELWELL
CLOSURE: 0.00 : 10.000
MAP PAGE(S): 7-00-024-A
APPROVED BY: JAH DATE: 4-7-03
SCALE: 1" = 400 PRIOR INSTRUMENT: OR 1034/639