
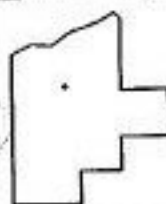


PARENT PARCEL: 03-00-007-102-032

CHILD PARCEL: 03-00-007-102-055, -056

STARTING POINT: CENTERLINE OF ABBE RD. & COLORADO AVE.

NO. 01346

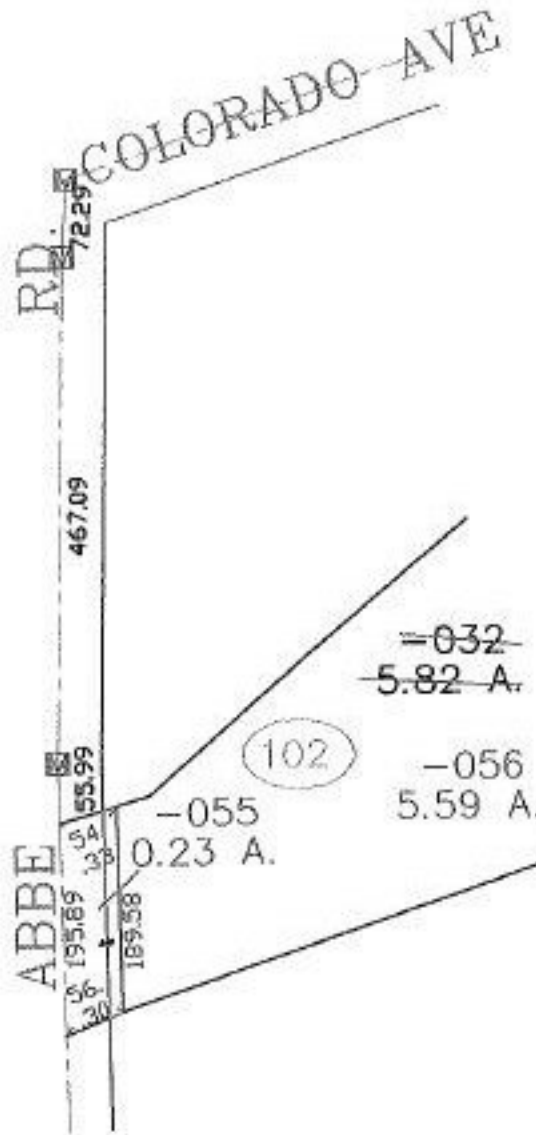

SPLITS/DEEDS PROCESSED
LORAIN COUNTY TAX MAP DEPARTMENT
 226 MIDDLE AVE. ELYRIA, OHIO

SURVEYED BY: NITIN V. TIMBLE
 CLOSURE: 0.00 : 10.000
 MAP PAGE(S): 03-00-007-A
 APPROVED BY: JAH DATE: 4-17-03
 SCALE: 1" = 200' PRIOR INSTRUMENT: OR 1079/887