
PARENT PARCEL: 02-01-003-501-040, -051, 02-01-004-501-042, -047

CHILD PARCEL: 02-01-003-501-054, 02-01-004-501-048

STARTING POINT: INT SOUTHERLY ROW OF ERIE AVE AND EASTERLY ROW OF BROADWAY

NO. 01352



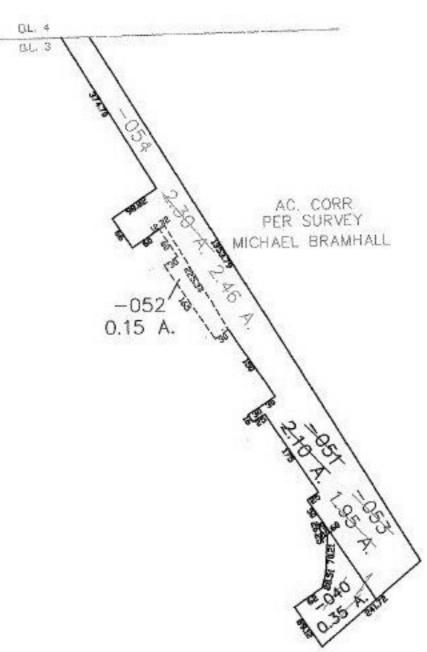

PAGE 1 OF 2

SPLITS/DEEDS PROCESSED

LORAIN COUNTY TAX MAP DEPARTMENT
226 MIDDLE AVE. ELYRIA, OHIO

SURVEYED BY: MICHAEL BRAMHALL

CLOSURE: 0: 00

MAP PAGE(S): 02-01-003-C

APPROVED BY: DRH DATE: 4/21/2003

SCALE: 1°= 200 PRIOR INSTRUMENT: