

PARENT PARCEL: 08-00-091-000-060

CHILD PARCEL: 08-00-091-000-065, -066


STARTING POINT: INT CL S.R 113 AND GIFFORD RD

NO. 01357



S.R. 113

GIFFORD RD 60'

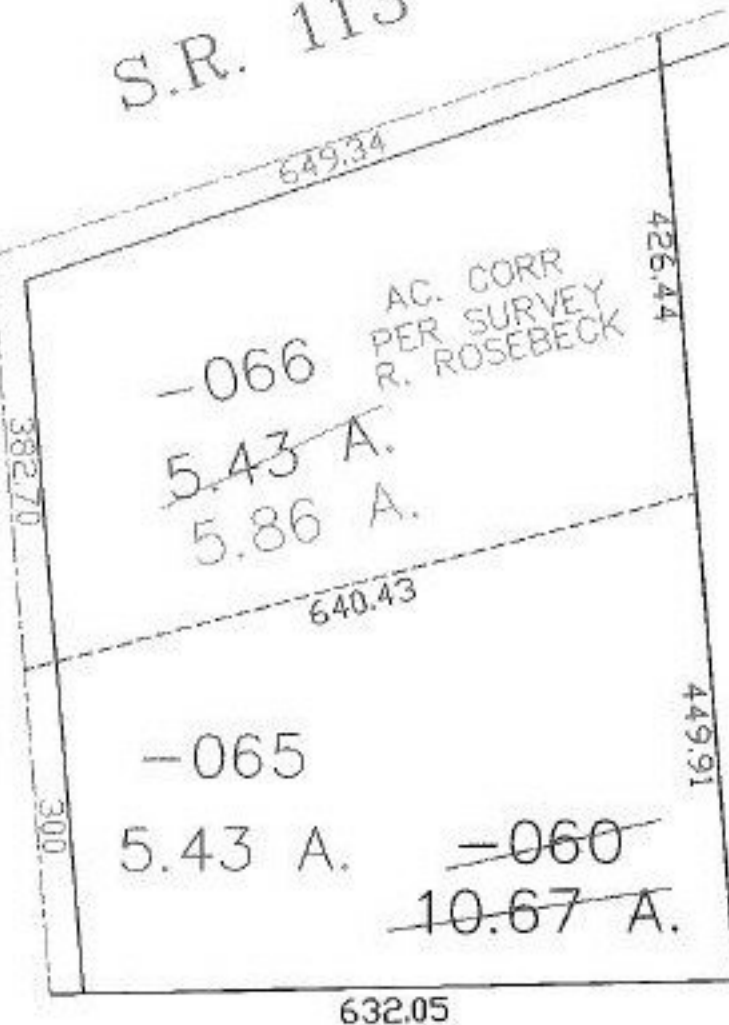

SPLITS/DEEDS PROCESSED
LORAIN COUNTY TAX MAP DEPARTMENT
226 MIDDLE AVE. ELYRIA, OHIO

SURVEYED BY: RICHARD ROSEBECK
CLOSURE: 0:00
MAP PAGE(S): 8-C
APPROVED BY: DRH DATE: 4/29/03
SCALE: 1" = 200' PRIOR INSTRUMENT: OR 1205/609