
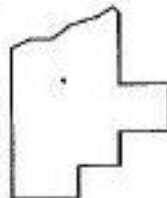


PARENT PARCEL: 11-00-092-000-055

CHILD PARCEL: 11-00-092-000-077, -078

STARTING POINT: INT. CL. DURKEE RD AND BUTTERNUT RIDGE RD

NO. 01359

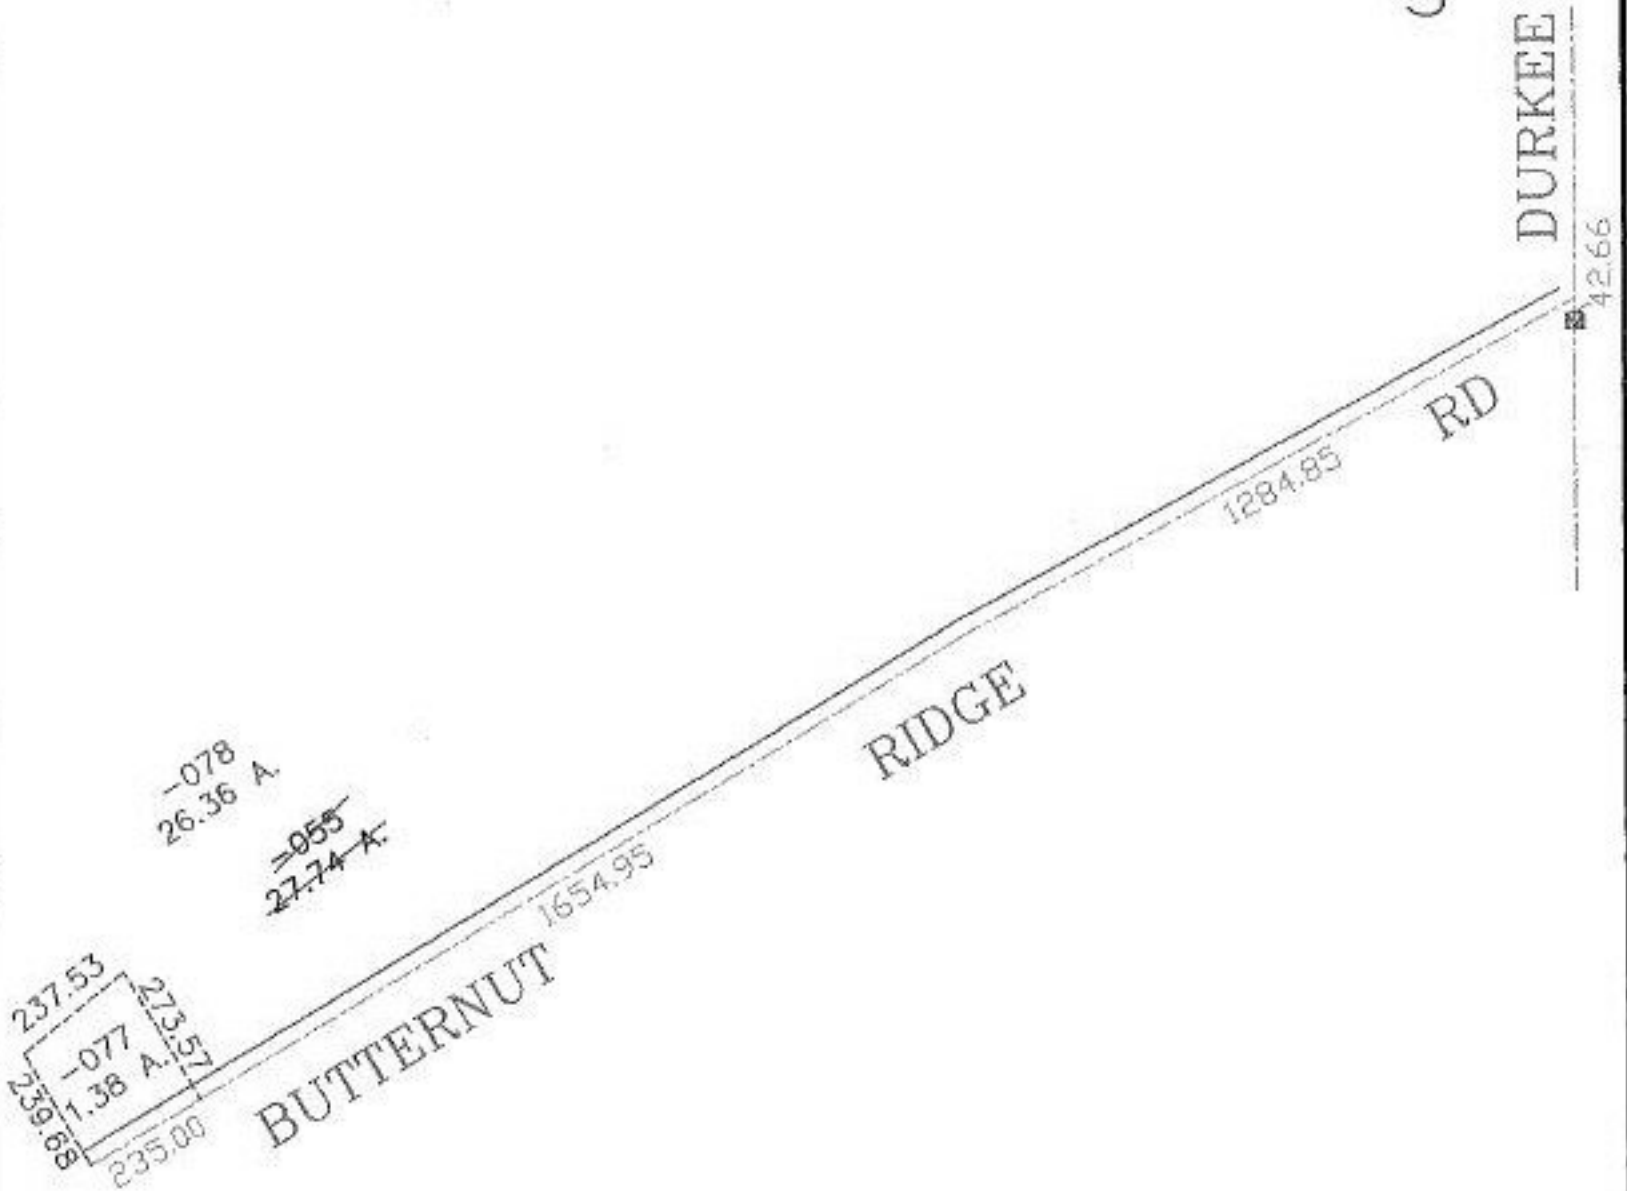

SPLITS/DEEDS PROCESSED
 LORAIN COUNTY TAX MAP DEPARTMENT
 226 MIDDLE AVE. ELYRIA, OHIO

SURVEYED BY: THOMAS A SIMON
 CLOSURE: 0:00
 MAP PAGE(S): 11-00-093-B
 APPROVED BY: DRH DATE: 4/30/2003
 SCALE: 1" = 400' PRIOR INSTRUMENT: 19990643156