



PARENT PARCEL: 10-00-002-000-032, 10-00-003-101-001  
CHILD PARCEL: 10-00-002-000-053, -054, -055, -056  
STARTING POINT: INT CL ALBRECHT RD AND NW CORNER OF S.L. 2

NO. 01360

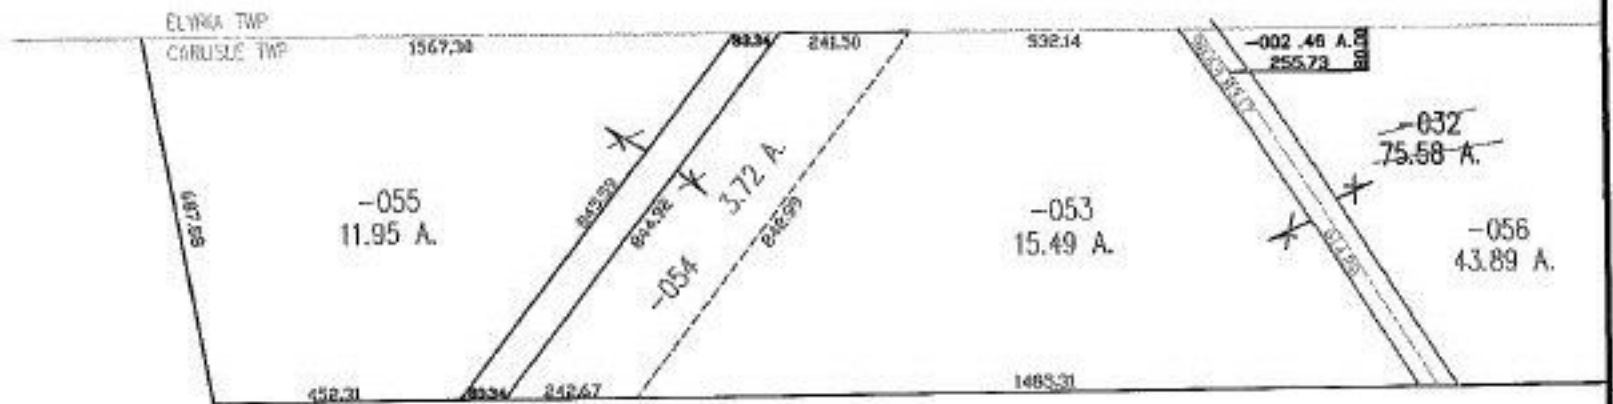

PLOT 1" = 100'

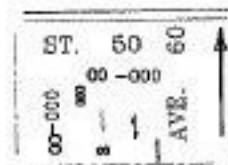

PAGE 1 OF 2



**SPLITS/DEEDS PROCESSED**  
LORAIN COUNTY TAX MAP DEPARTMENT  
226 MIDDLE AVE. ELYRIA, OHIO

SURVEYED BY: JAMES B. ROOT  
CLOSURE: 0:00  
MAP PAGE(S): 10-00-003-A  
APPROVED BY: DRH DATE: 5/2/2003  
SCALE: 1" = 400' PRIOR INSTRUMENT: DV 1385/780