


PARENT PARCEL: 05-00-055-000-022, -023

CHILD PARCEL: 05-00-055-000-037

STARTING POINT: CENTERLINE OF OBERLIN RD. & OHIO TURNPIKE

NO. 01365

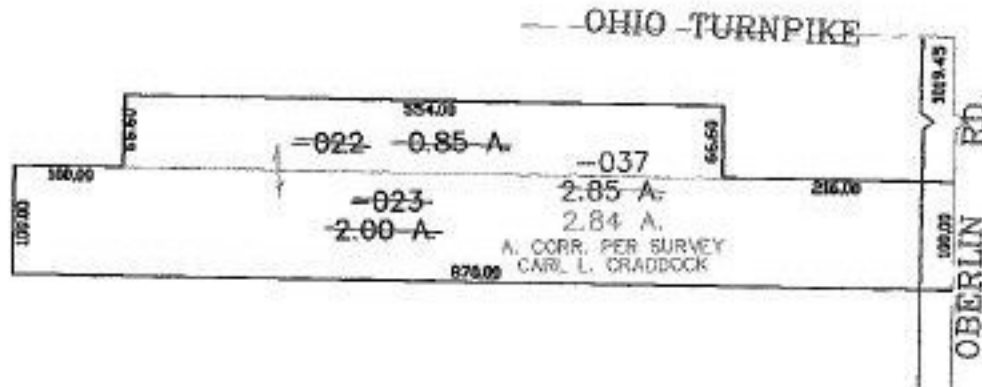

SPLITS/DEEDS PROCESSED
LORAIN COUNTY TAX MAP DEPARTMENT
 226 MIDDLE AVE. ELYRIA, OHIO

SURVEYED BY: CARL L. CRADDOCK
 CLOSURE: 0.00 : 10.000
 MAP PAGE(S): 5-G
 APPROVED BY: JAH DATE: 6-12-03
 SCALE: 1" = 200 PRIOR INSTRUMENT: 19990594552