
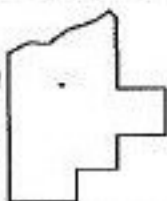


PARENT PARCEL: 04-00-024-109-005

CHILD PARCEL: 04-00-024-109-110, -111

STARTING POINT: CENTERLINE OF HEATHERWOOD LN & S/L 12

NO. 01368

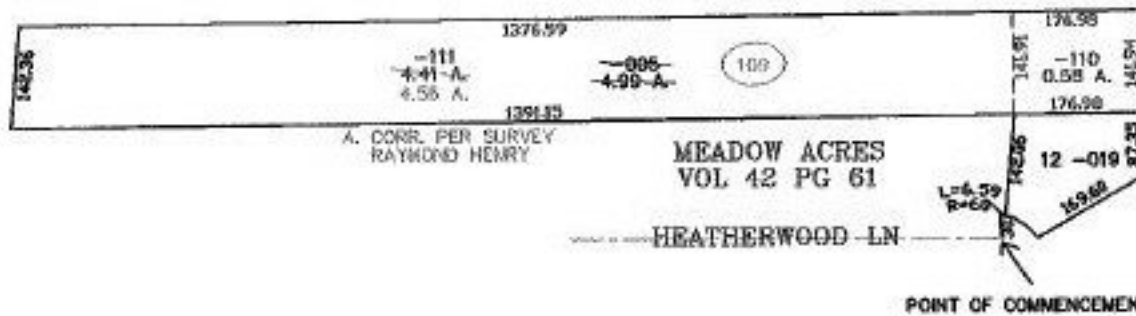

**SPLITS/DEEDS PROCESSED**  
 LORAIN COUNTY TAX MAP DEPARTMENT  
 226 MIDDLE AVE. ELYRIA, OHIO

SURVEYED BY: RAYMOND HENRY  
 CLOSURE: 0.00 : 10.000  
 MAP PAGE(S): 04-00-024-6  
 APPROVED BY: JAH DATE: 5-12-03  
 SCALE: 1" = 300' PRIOR INSTRUMENT: 970508005