


PARENT PARCEL: 04-00-016-101-042

CHILD PARCEL: 04-00-016-101-188 THRU -190

STARTING POINT: CENTERLINE OF CENTER RD. & CHESTER RD.

NO. 01369

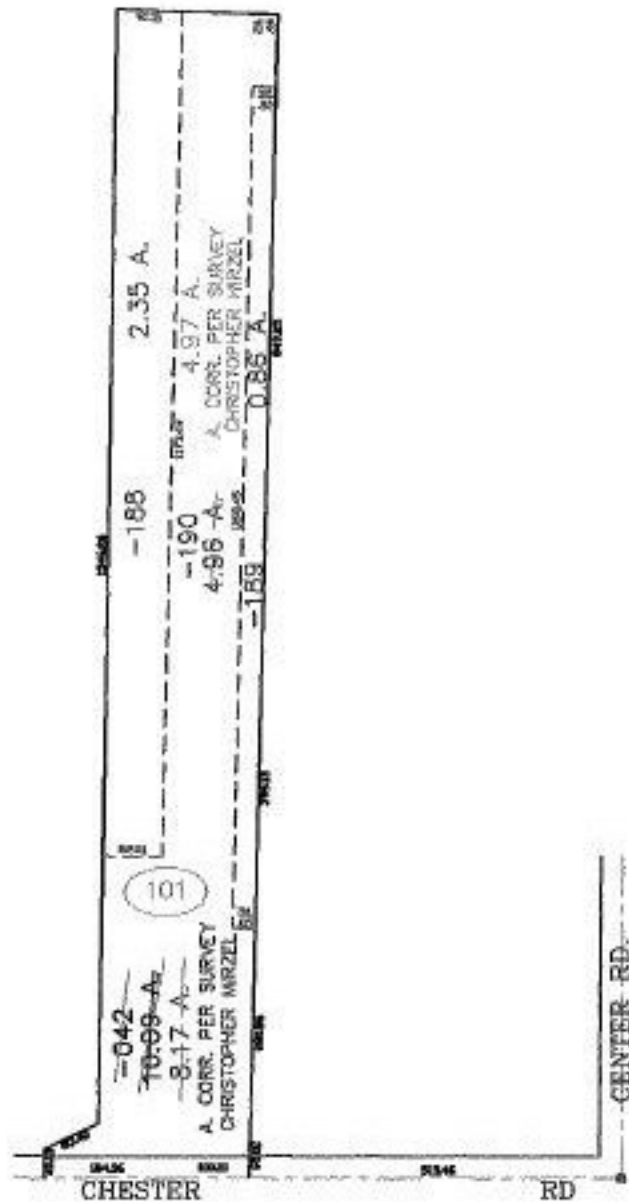

**SPLITS/DEEDS PROCESSED**  
**LORAIN COUNTY TAX MAP DEPARTMENT**  
 226 MIDDLE AVE. ELYRIA, OHIO

SURVEYED BY: CHRISTOPHER HIRZEL  
 CLOSURE: 0.00 : 10.000  
 MAP PAGE(S): 04-00-016-F  
 APPROVED BY: JAH DATE: 6-4-03  
 SCALE: 1" = 300' PRIOR INSTRUMENT: OR 997/550