
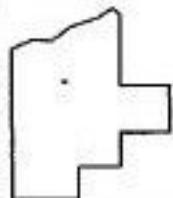


PARENT PARCEL: 03-00-075-115-012, -015

CHILD PARCEL: 03-00-075-115-020 THRU -023

STARTING POINT: CENTERLINE OF NORTH RIDGE RD. & WEST RIVER RD.

NO. 01370

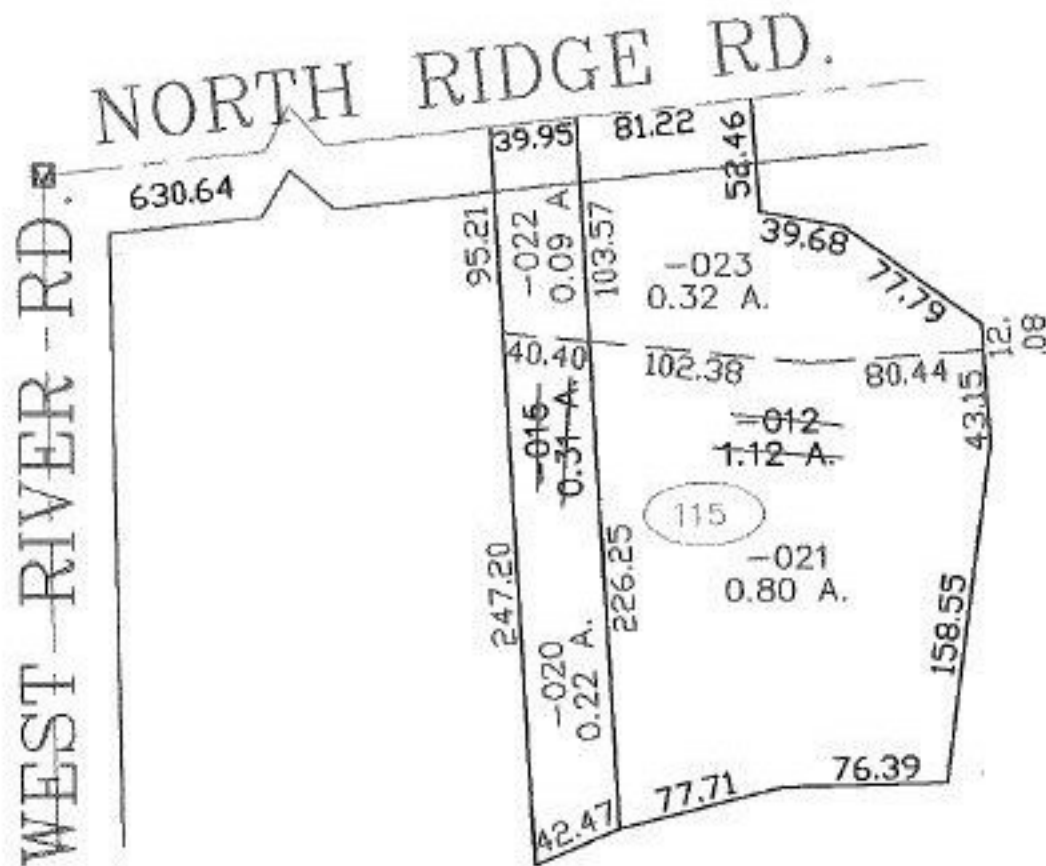

SPLITS/DEEDS PROCESSED

LORAIN COUNTY TAX MAP DEPARTMENT
226 MIDDLE AVE. ELYRIA, OHIO

SURVEYED BY: THOMAS A. SIMON

CLOSURE: 0.01 : 10.000

MAP PAGE(S): 03-00-075-C

APPROVED BY: JAH DATE: 5-19-03

SCALE: 1" = 100' PRIOR INSTRUMENT: DV 1154/419