


RASTER

PARENT PARCEL: 09-00-058-000-025

CHILD PARCEL: 09-00-058-000-027, -028


STARTING POINT: CENTERLINE OF BUTTERNUT RIDGE RD. & OBERLIN RD.

NO. 01372

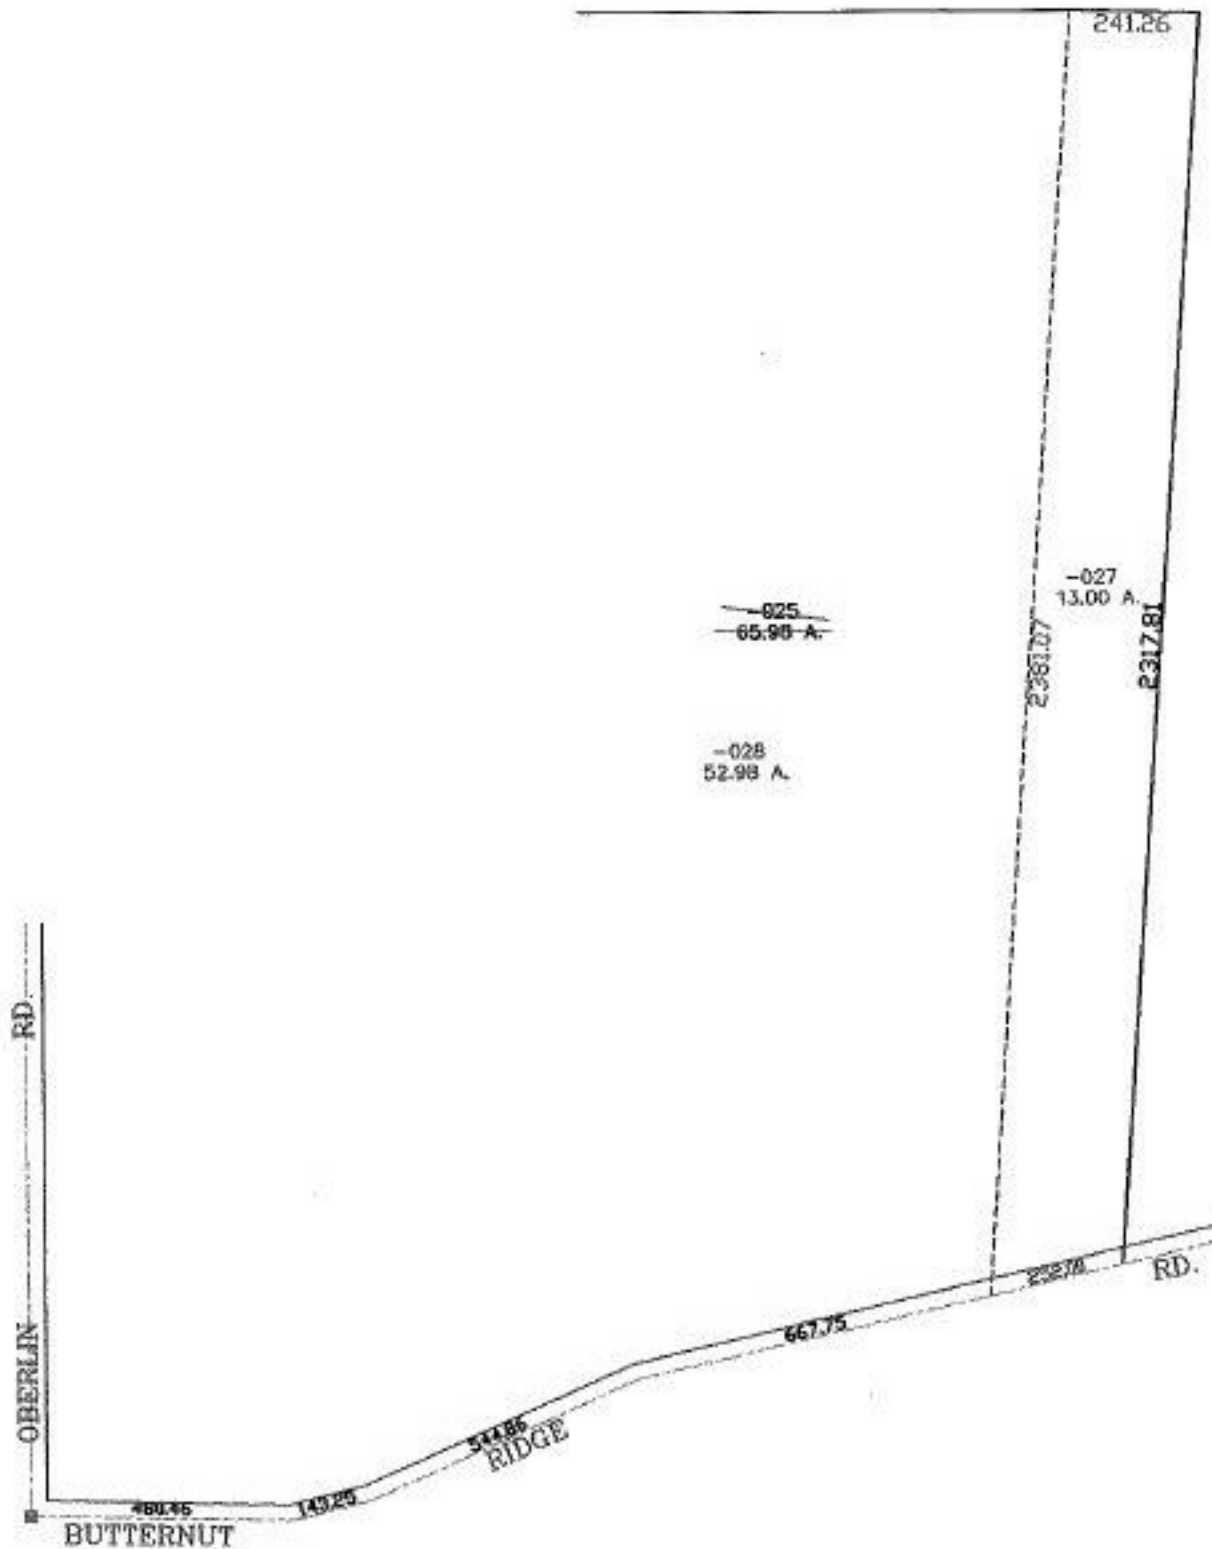

OBERLIN RD.

BUTTERNUT

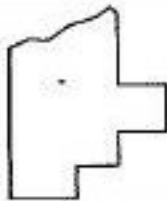

SPLITS/DEEDS PROCESSED

LORAIN COUNTY TAX MAP DEPARTMENT
226 MIDDLE AVE. ELYRIA, OHIO

SURVEYED BY: RICHARD D. CARLSON

CLOSURE: 0.01 : 10,000

MAP PAGE(S): 9-H

APPROVED BY: JAH DATE: 05/22/03

SCALE: 1" = 400' PRIOR INSTRUMENT: 20020817190