


PARENT PARCEL: 02-02-012-101-011, 017 02-02-012-101-003, -011
 CHILD PARCEL: 02-02-012-101-014 THRU -019 02-02-011-000-103, -104
 STARTING POINT: CENTERLINE OF JONES DR. & MARTINS RUN DR.

NO. 01376

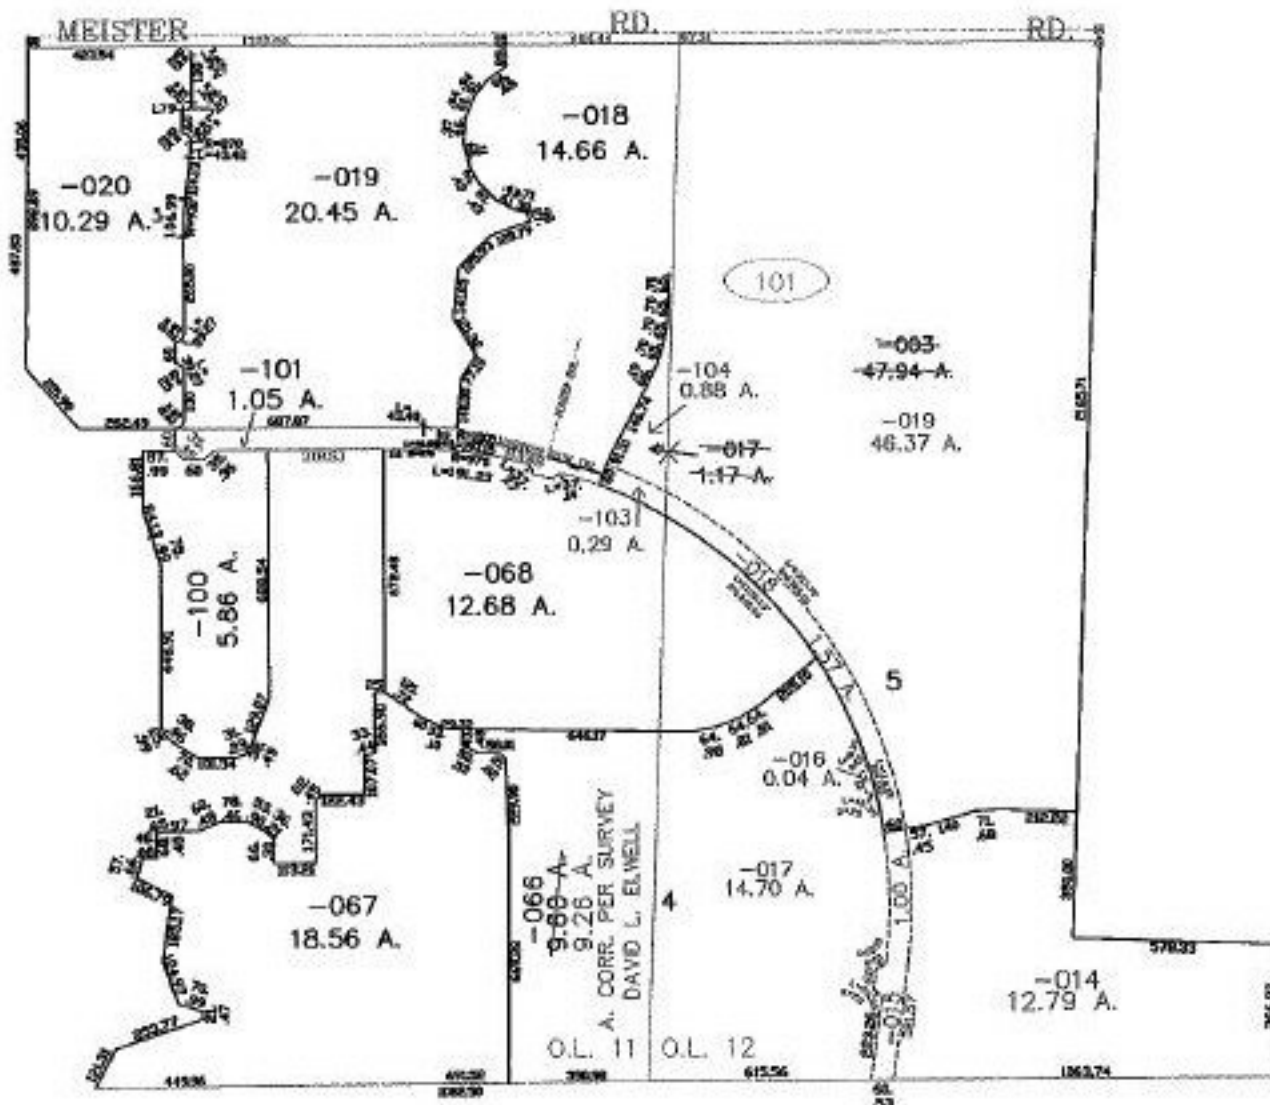

SPLITS/DEEDS PROCESSED
 LORAIN COUNTY TAX MAP DEPARTMENT
 226 MIDDLE AVE. ELYRIA, OHIO

SURVEYED BY: DAVID L. ELWELL
 CLOSURE: 0.01 : 10,000
 MAP PAGE(S): 2-F, 02-03-001-B, 02-02-011-A
 APPROVED BY: JAH DATE: 5-29-03
 SCALE: 1" = 600' PRIOR INSTRUMENT: 20020857301