


PARENT PARCEL: 05-00-099-000-067
CHILD PARCEL: 05-00-099-000-194 THRU -196
STARTING POINT: CENTERLINE OF COOPER FOSTER PARK RD. & QUARRY RD.

NO. 01389

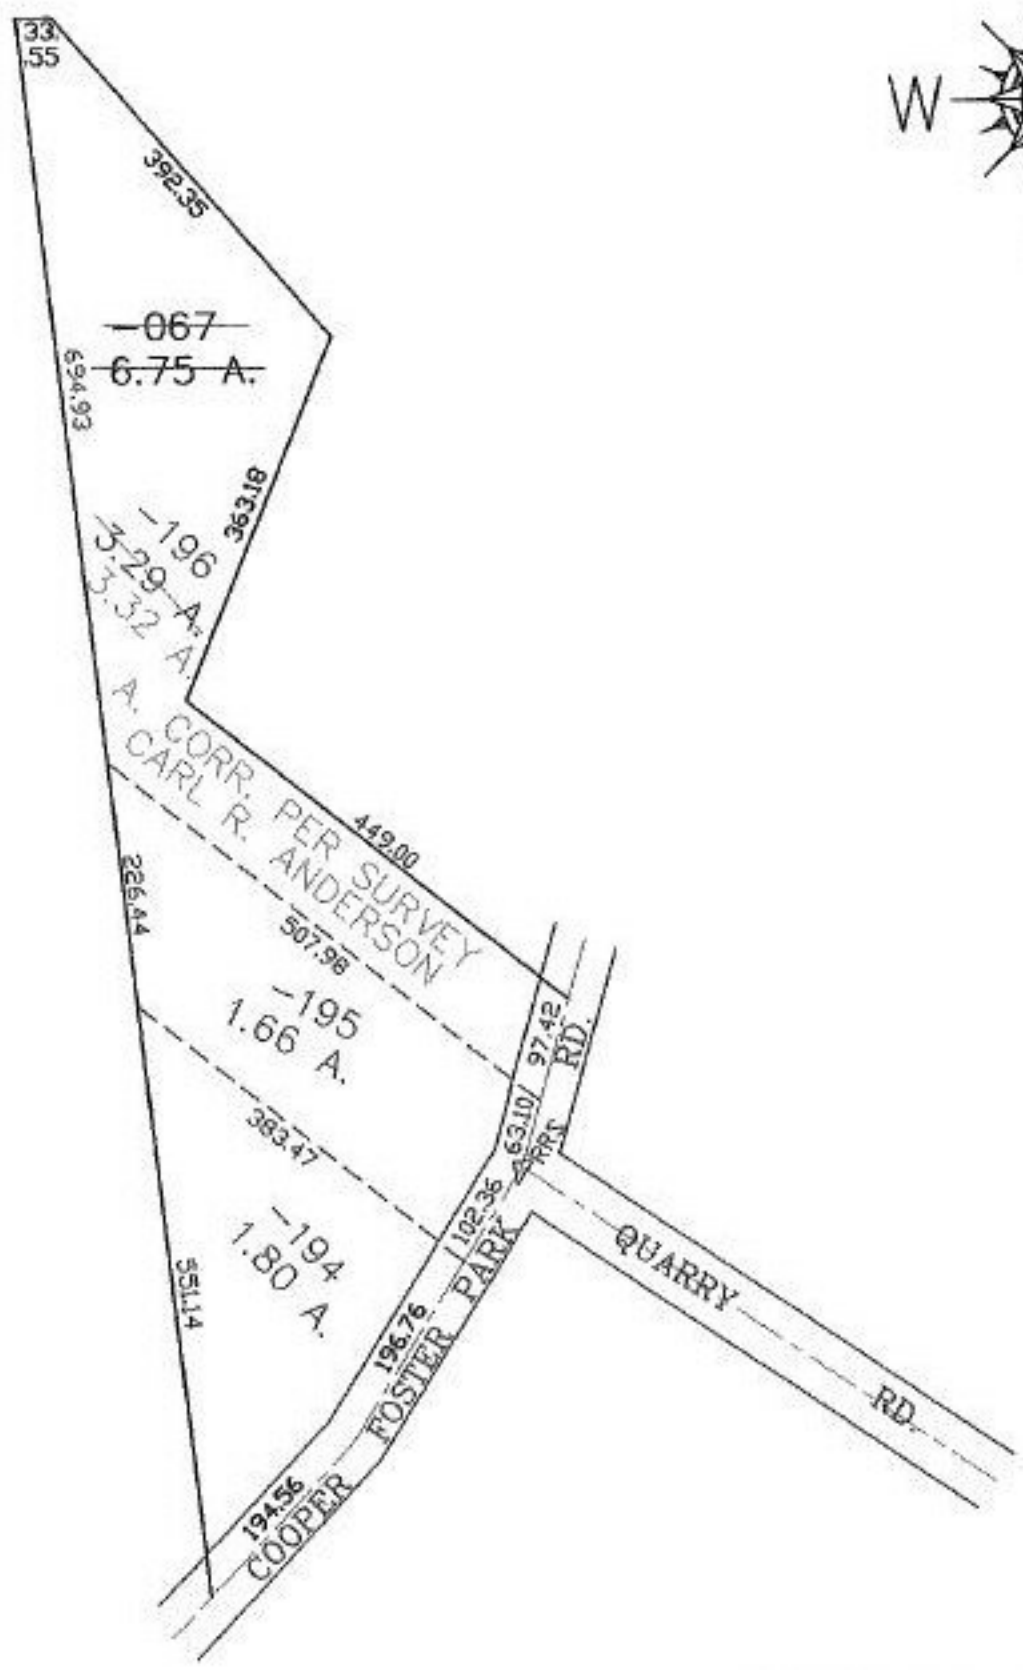

SPLITS/DEEDS PROCESSED
LORAIN COUNTY TAX MAP DEPARTMENT
226 MIDDLE AVE. ELYRIA, OHIO

SURVEYED BY: CARL R. ANDERSON
CLOSURE: 0.00 : 10.000
MAP PAGE(S): 5-00-099-C
APPROVED BY: JAH DATE: 6-11-03
SCALE: 1" = 200' PRIOR INSTRUMENT: 20020869081