

RASTER

PARENT PARCEL: 04-00-029-000-416

CHILD PARCEL: 04-00-029-000-550, -551

STARTING POINT: CENTERLINE OF LEAR RD. & HANDFORD BLVD.

NO. 01390



LEAR RD.

100.00

208.84

HANDFORD


R=850

50.00

L=56.82
R=750

BLVD.

L=72.71
R=750

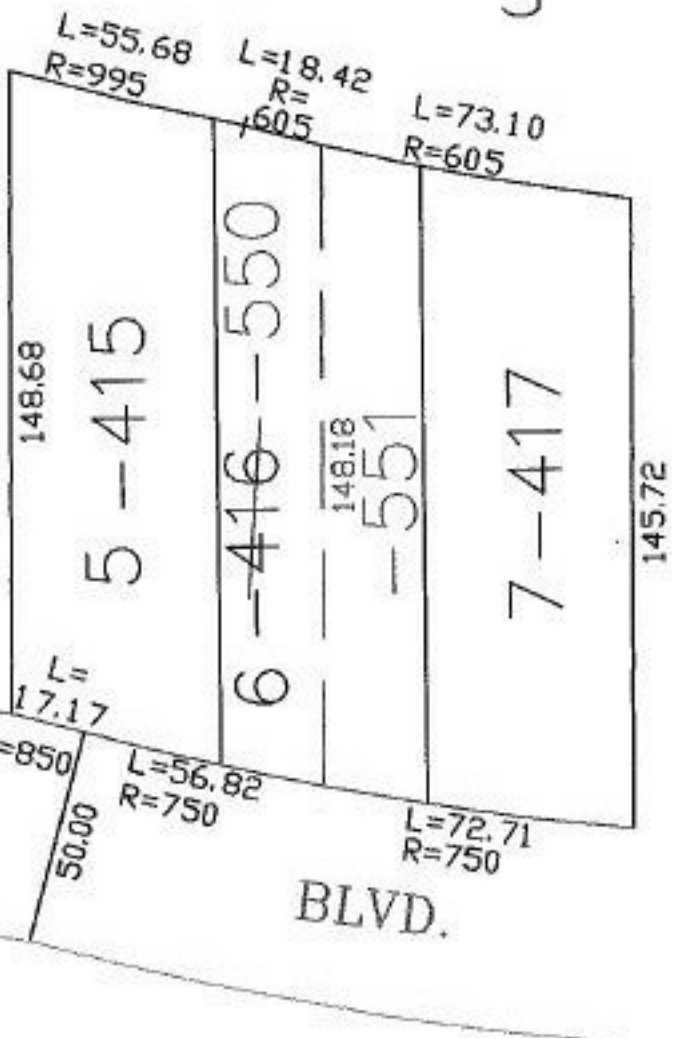

SPLITS/DEEDS PROCESSED

LORAIN COUNTY TAX MAP DEPARTMENT
226 MIDDLE AVE. ELYRIA, OHIO

SURVEYED BY: JAMES T. SAYLOR

CLOSURE: 0.00 : 10.000

MAP PAGE(S): 04-00-029-A

APPROVED BY: JAH DATE: 6-12-03

SCALE: 1" = 50' PRIOR INSTRUMENT: PL. VL 74/32