


MASTER

PARENT PARCEL: 12-00-081-000-051

CHILD PARCEL: 12-00-081-000-069, -070

STARTING POINT: CENTERLINE OF SPRAGUE RD. & MITCHELL RD.

NO. 01391

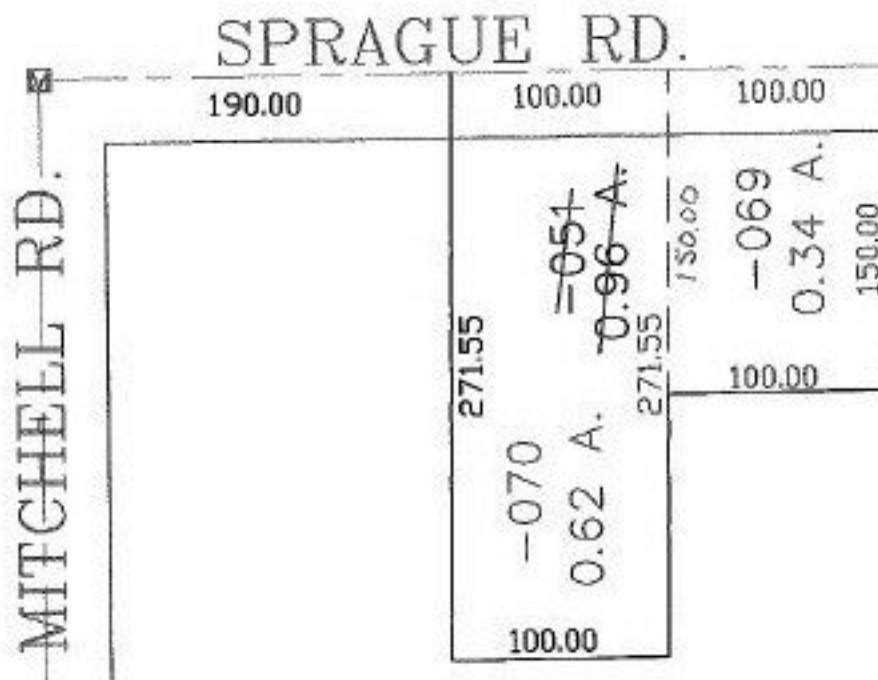

**SPLITS/DEEDS PROCESSED**

LORAIN COUNTY TAX MAP DEPARTMENT  
226 MIDDLE AVE. ELYRIA, OHIO

SURVEYED BY: RONALD GARNETT  
 CLOSURE: 0.00 : 10.000  
 MAP PAGE(S): 12-00-081-B  
 APPROVED BY: JAH DATE: 7-3-03  
 SCALE: 1" = 100' PRIOR INSTRUMENT: DV 1029/920

Master