


PARENT PARCEL: 03-00-054-105-029

CHILD PARCEL: 03-00-054-105-032, -033

STARTING POINT: CENTERLINE OF COLORADO AVE. & O.L. 54

NO. 01401

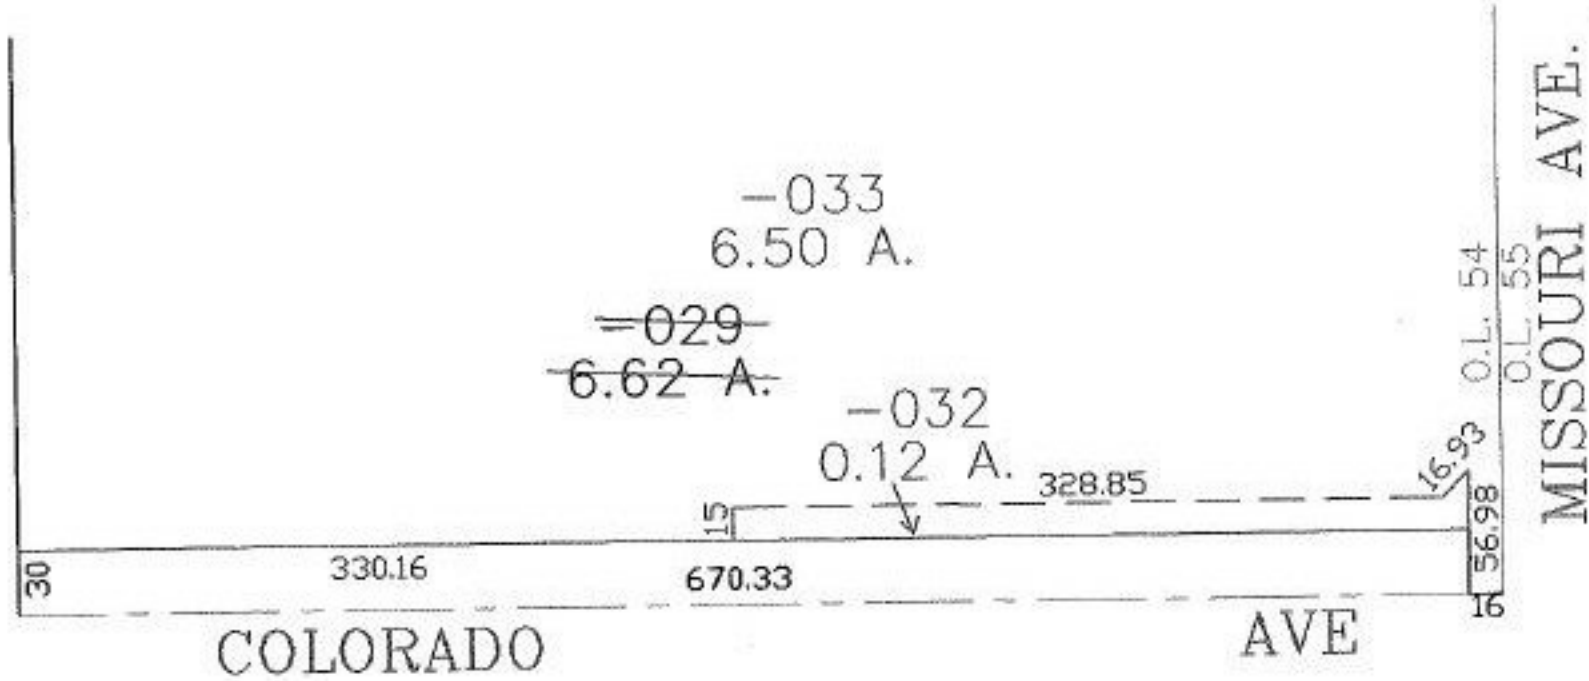

30

330.16

670.33

16.93 O.L. 54
56.98 O.L. 55
16

COLORADO

AVE

MISSOURI AVE.



SPLITS/DEEDS PROCESSED

LORAIN COUNTY TAX MAP DEPARTMENT
226 MIDDLE AVE. ELYRIA, OHIO

SURVEYED BY: BRIAN P. MCCARTNEY
 CLOSURE: 0.00 : 10.000
 MAP PAGE(S): 03-00-054-B
 APPROVED BY: JAH DATE: 6-27-03
 SCALE: 1" = 100 PRIOR INSTRUMENT: 20020866172