



RASTER

PARENT PARCEL: 16-00-023-000-020, 16-00-018-103-028, -021

CHILD PARCEL: 16-00-023-023-000-021 THRU -024 16-00-018-103-030 THRU -038

STARTING POINT: CENTERLINE OF MENNELL RD. & O.L. 23

NO. 01402

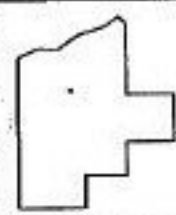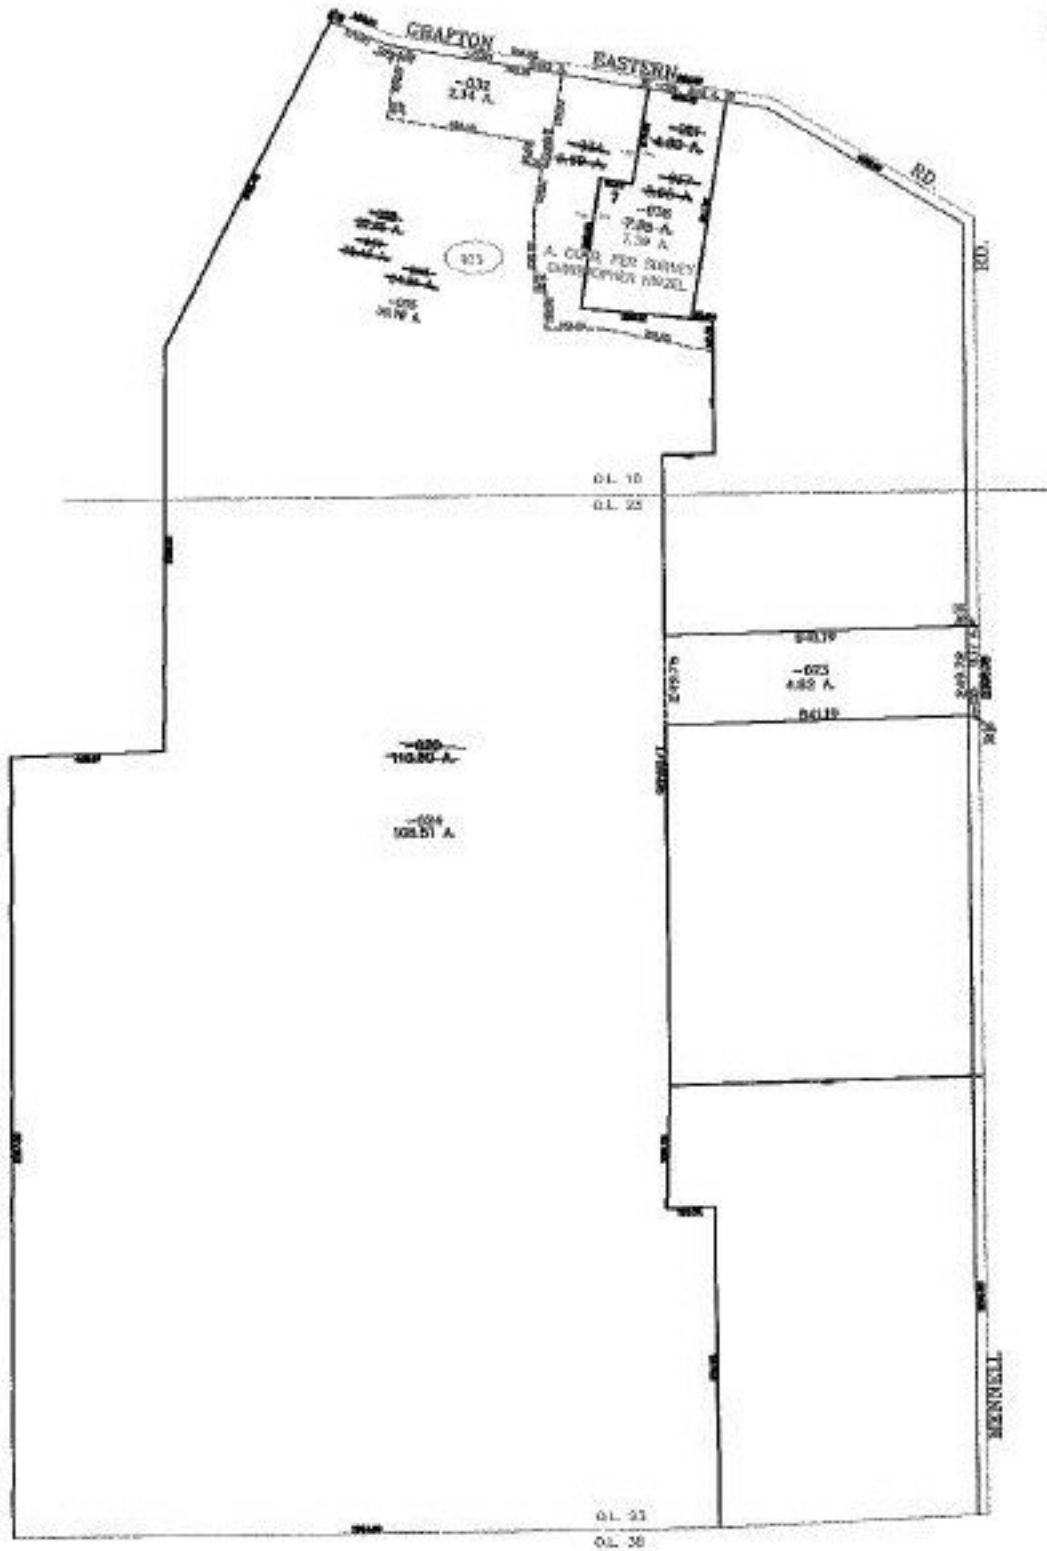

SPLITS/DEEDS PROCESSED

LORAIN COUNTY TAX MAP DEPARTMENT
226 MIDDLE AVE. ELYRIA, OHIO

SURVEYED BY: CHRISTOPHER HIRZEL

CLOSURE: 0.01 : 10.000

MAP PAGE(S): 16-00-023-B 16-00-018-A,B

APPROVED BY: JAH DATE: 6-30-03

SCALE: 1" = 600 PRIOR INSTRUMENT: OR 131/659