
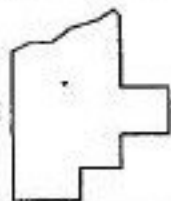


RASTER

PARENT PARCEL: 16-00-023-000-020, 16-00-018-103-028, -021
CHILD PARCEL: 16-00-023-023-000-021 THRU -024 16-00-018-103-030 THRU -038
STARTING POINT: CENTERLINE OF MENNELL RD. & O.L. 23

NO. 01402

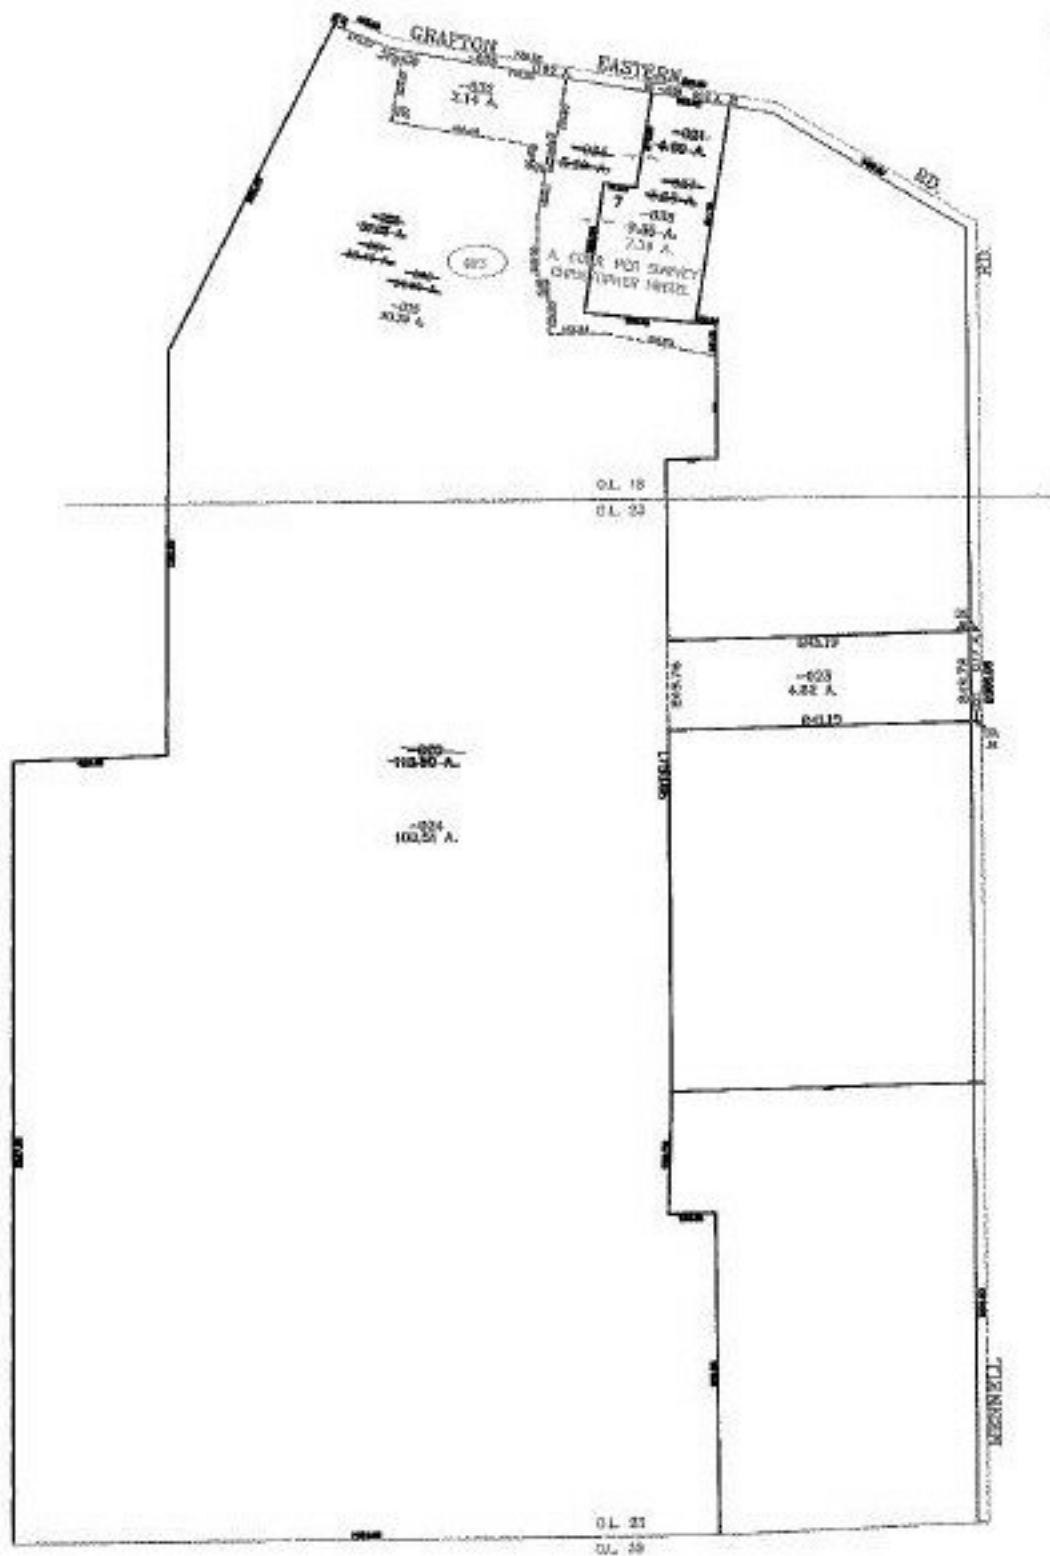

SPLITS/DEEDS PROCESSED

LORAIN COUNTY TAX MAP DEPARTMENT
226 MIDDLE AVE. ELYRIA, OHIO

SURVEYED BY: CHRISTOPHER HIRZEL
CLOSURE: 0.01 : 10.000
MAP PAGE(S): 16-00-023-B 16-00-018-A,B
APPROVED BY: JAH DATE: 6-30-03
SCALE: 1" = 600' PRIOR INSTRUMENT: OR 131/659