



RASTER

PARENT PARCEL: 04-00-015-110-152 THRU -156 & -158

CHILD PARCEL: 04-00-015-110-160 THRU -162

STARTING POINT: CENTERLINE OF FALCON CREST AVE. & AVON CENTER RD.

NO. 01404

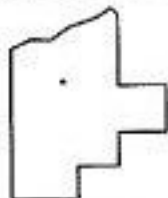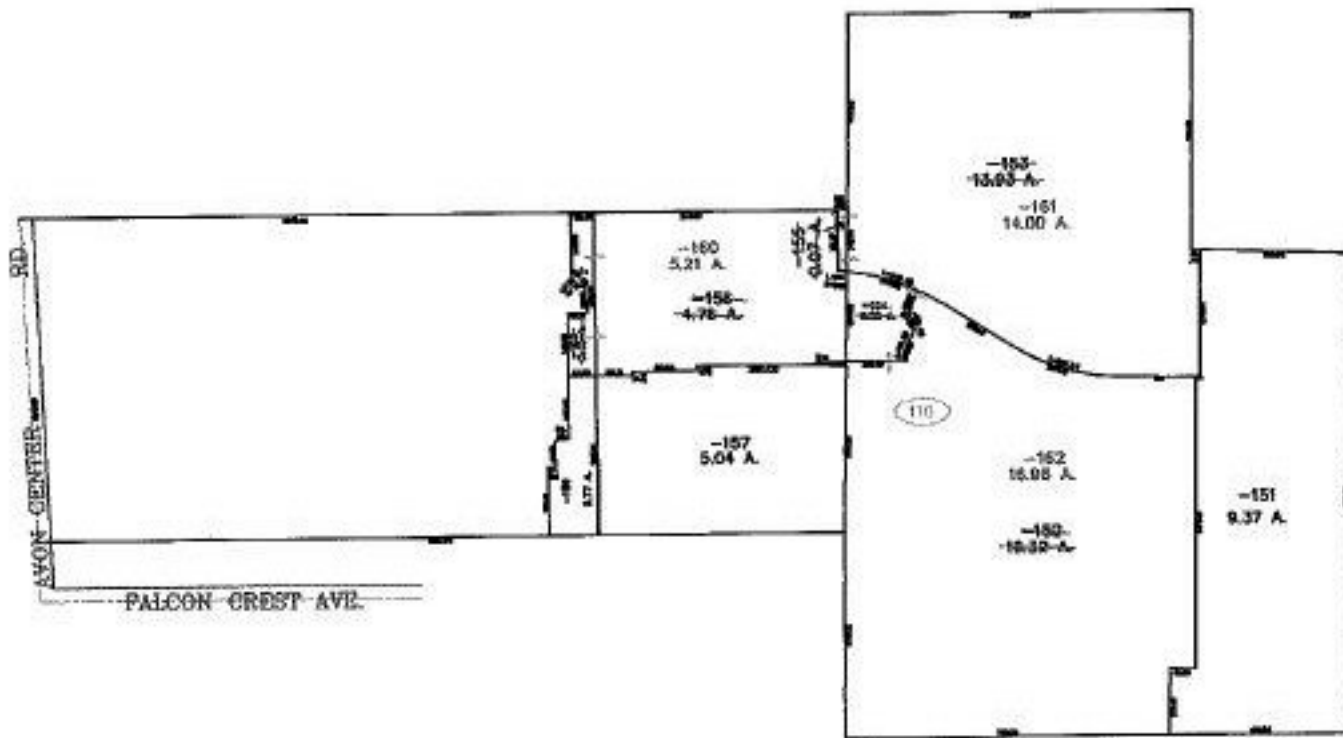

SPLITS/DEEDS PROCESSED

LORAIN COUNTY TAX MAP DEPARTMENT
226 MIDDLE AVE. ELYRIA, OHIO

SURVEYED BY: RICHARD A. THOMPSON

CLOSURE: 0.00 : 10.000

MAP PAGE(S): 04-00-015-C

APPROVED BY: JAH DATE: 8-1-03

SCALE: 1" = 500' PRIOR INSTRUMENT: 20020833687