


PARENT PARCEL: 06-25-126-000-005

CHILD PARCEL: 06-25-126-000-006, -007

STARTING POINT: SIDELINE OF WASHINGTON AVE. & O.L. 126

NO. 01405

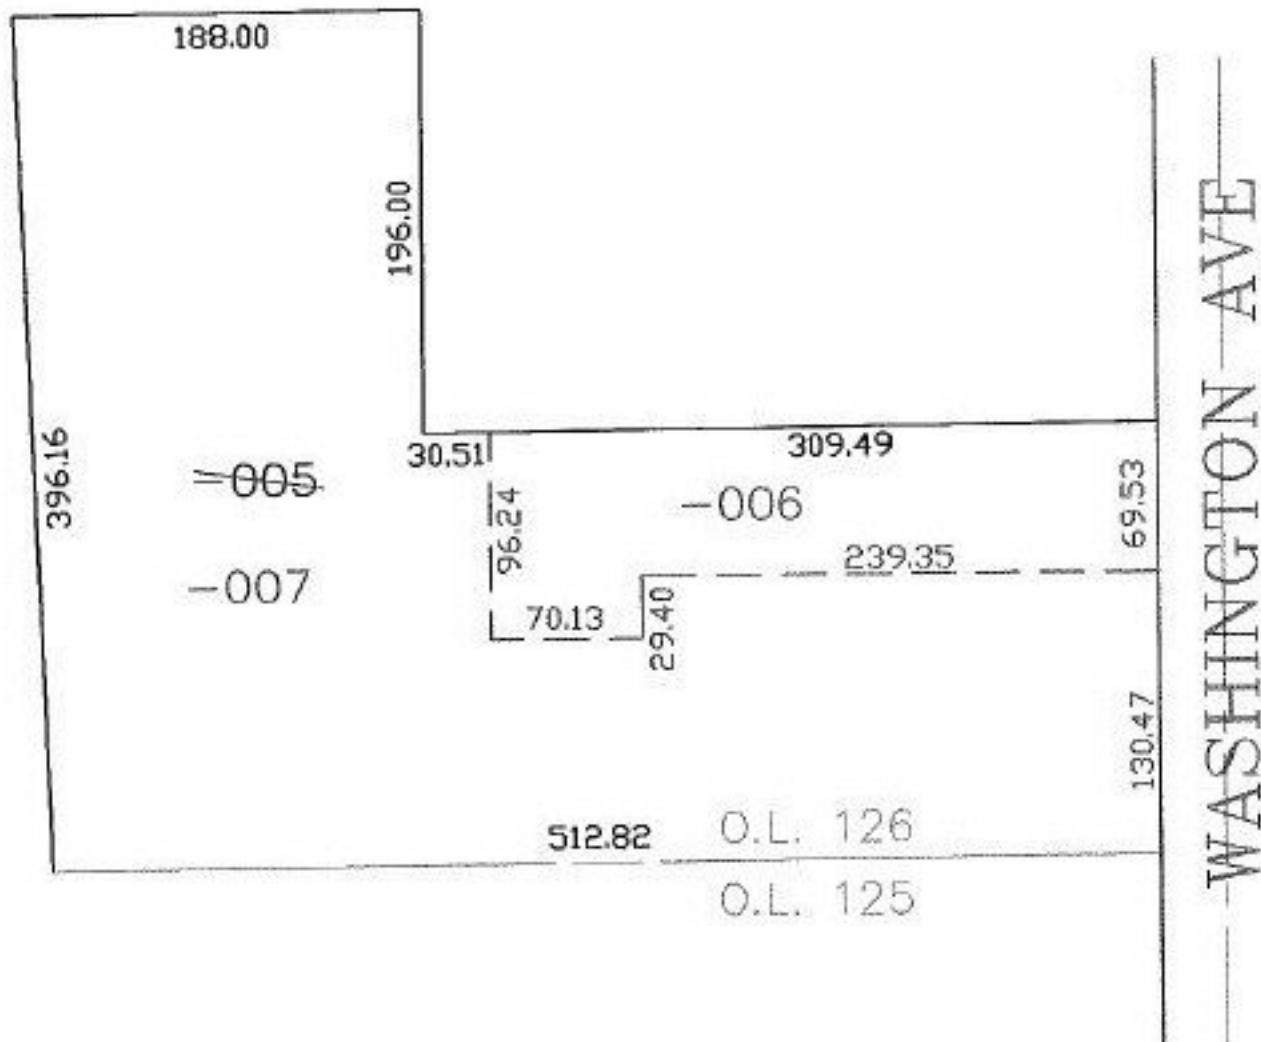

**SPLITS/DEEDS PROCESSED**  
 LORAIN COUNTY TAX MAP DEPARTMENT  
 226 MIDDLE AVE. ELYRIA, OHIO

SURVEYED BY: DOUG MOSLEY  
 CLOSURE: 0.00 : 10.000  
 MAP PAGE(S): 6-101  
 APPROVED BY: JAH DATE: 7-2-03  
 SCALE: 1" = 100' PRIOR INSTRUMENT: DV 504/467