

PARENT PARCEL: 01-00-003-139-020

CHILD PARCEL: 01-00-003-139-037 THRU -039

STARTING POINT: NORTHWEST CORNER OF BLOCK 1

NO. 01409

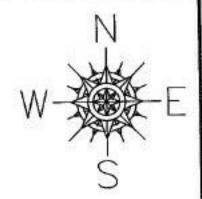

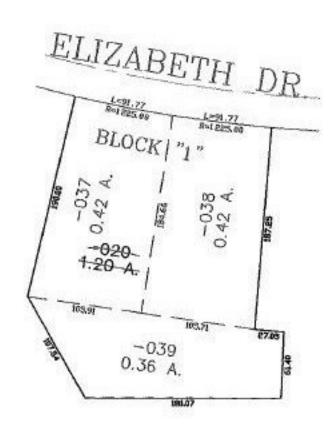

SPLITS/DEEDS PROCESSED

LORAIN COUNTY TAX MAP DEPARTMENT 226 MIDDLE AVE. ELYRIA, OHIO SURVEYED BY: DOUGLAS MOSLEY

CLOSURE: 0.00 : 10,000

MAP PAGE(S): 01-00-003-C

APPROVED BY: JAH DATE: 7-14-03

SCALE: 1"= 100 PRIOR INSTRUMENT: 20000723771